

# SUITE: 1400

# RSF: 4,274



# 700 BRAND

## AS-BUILT CONFIGURATION

PRIVATE OFFICES.....	4
RECEPTION.....	1
CONFERENCE ROOMS.....	1
KITCHEN.....	1
OPEN WORK AREA.....	+/- 32

*Not to scale, furniture and appliances not included*

## KEY PLAN

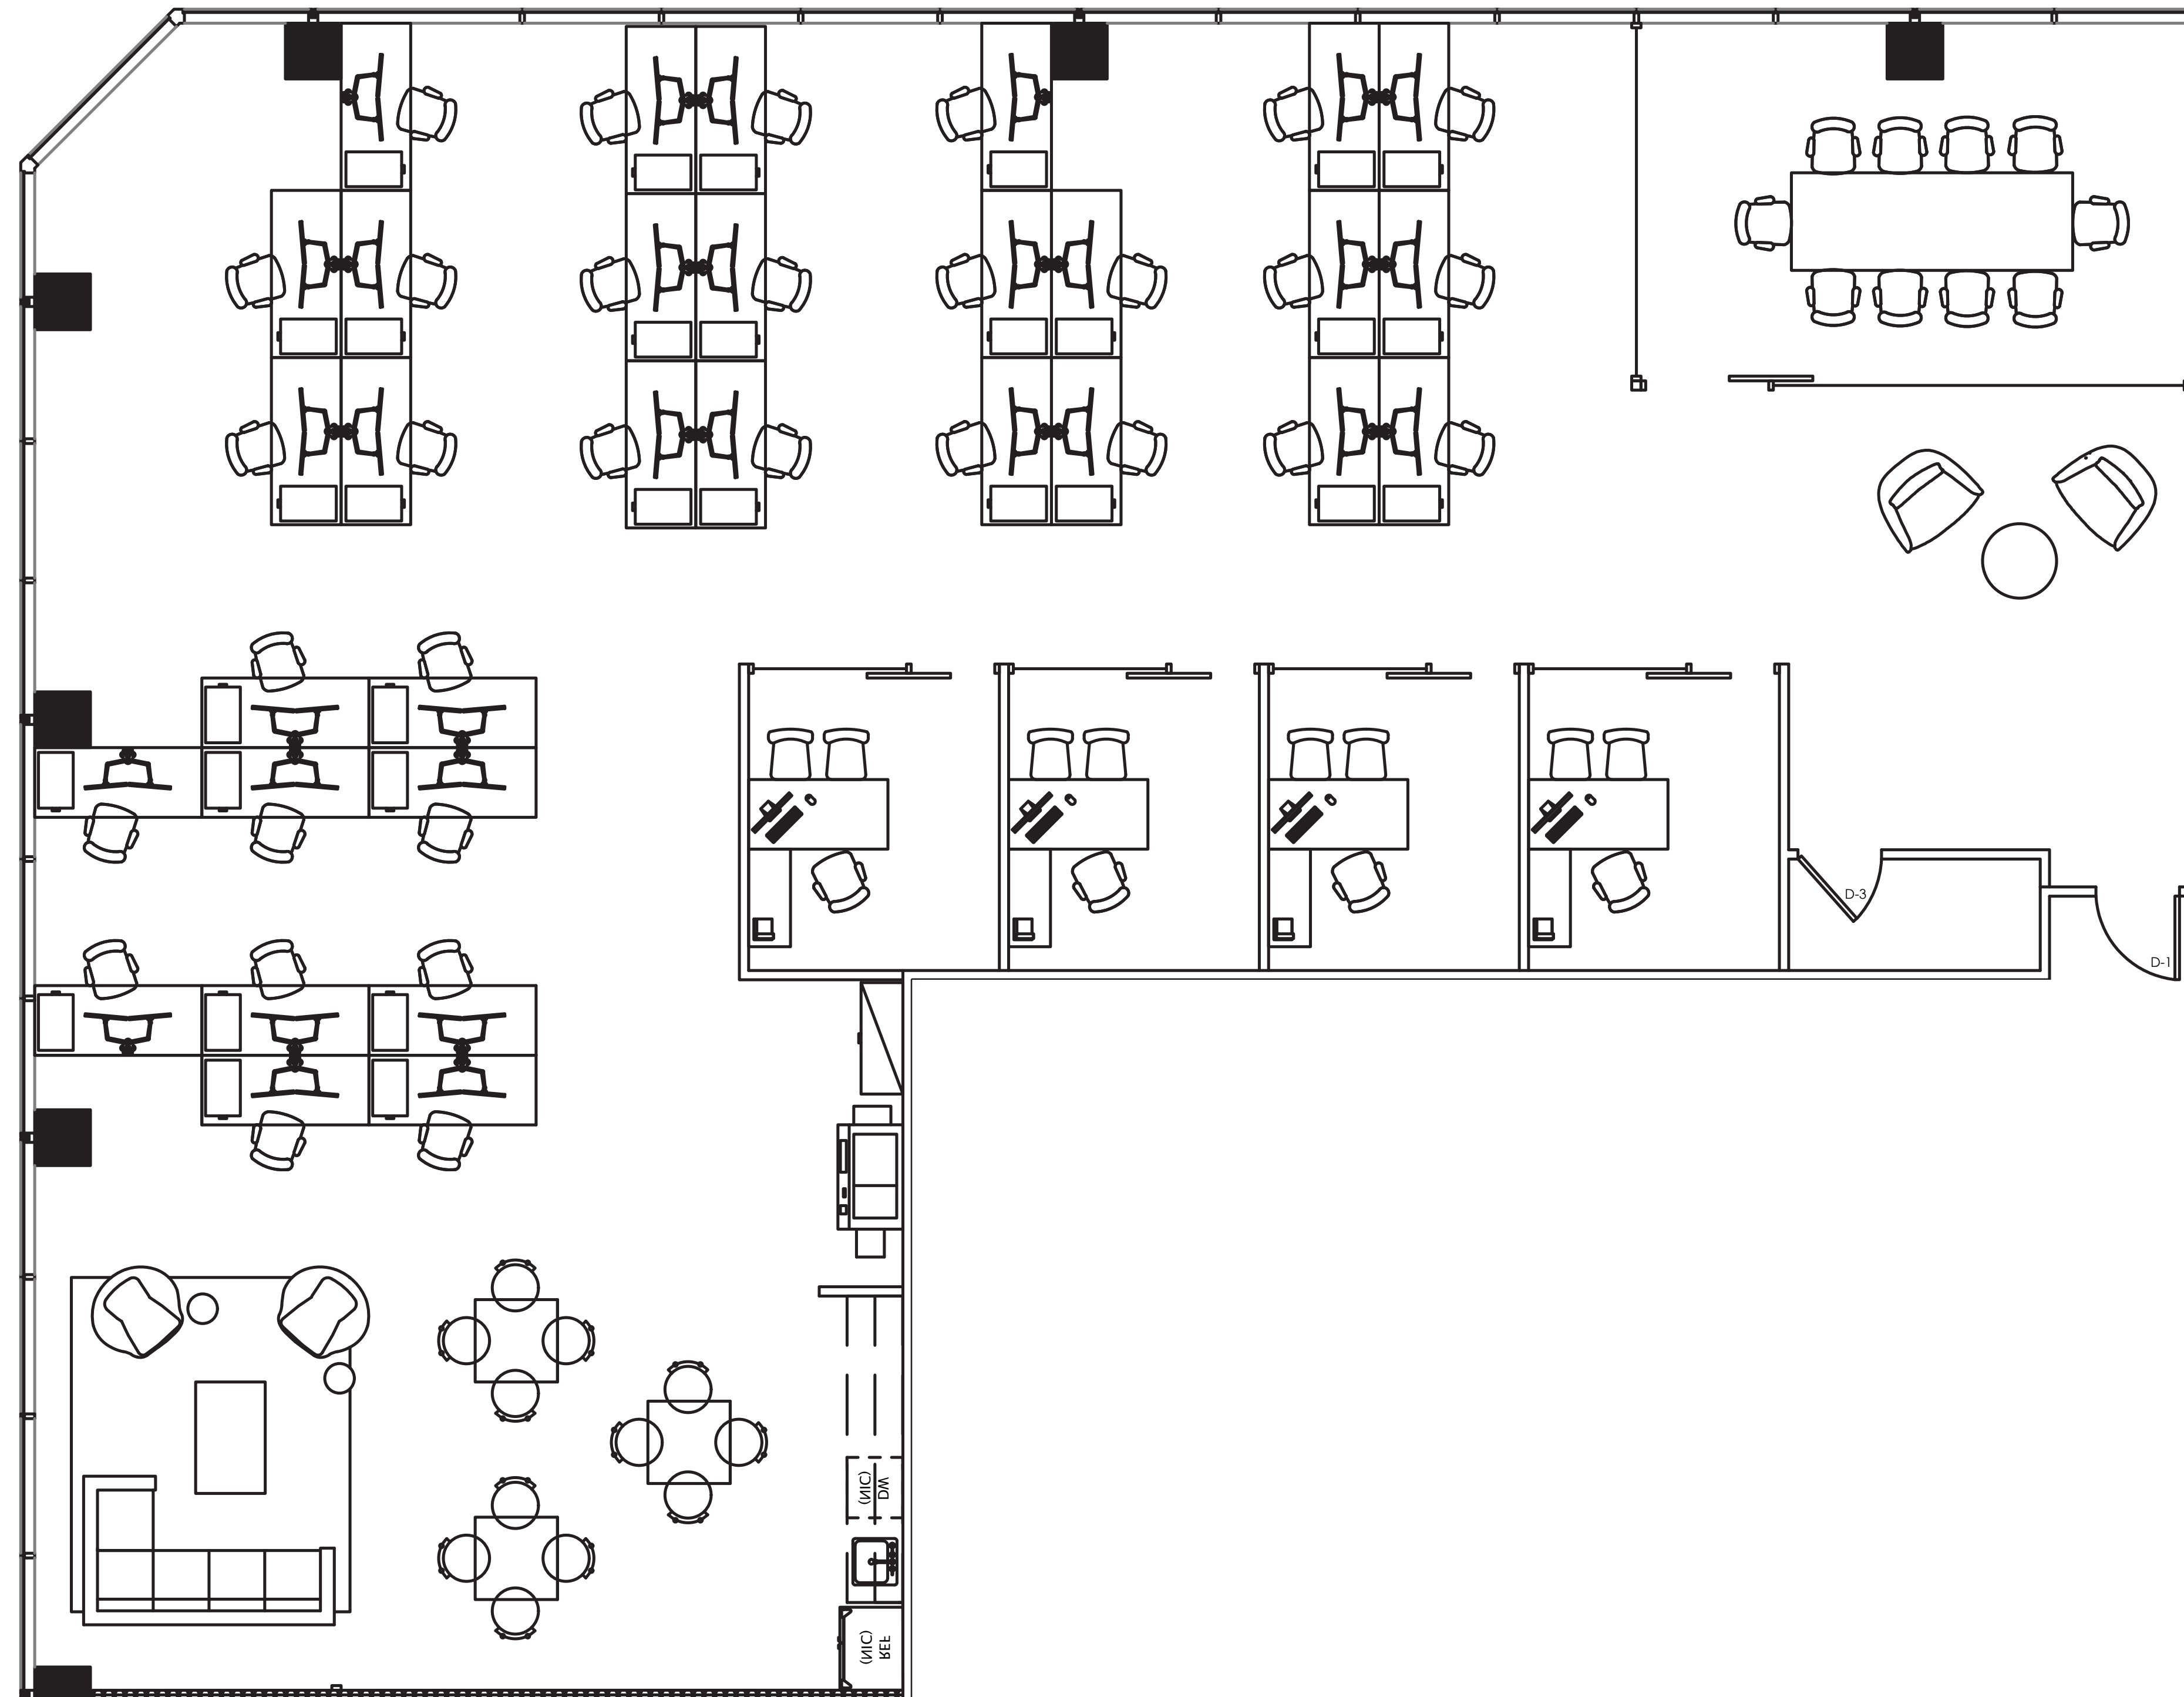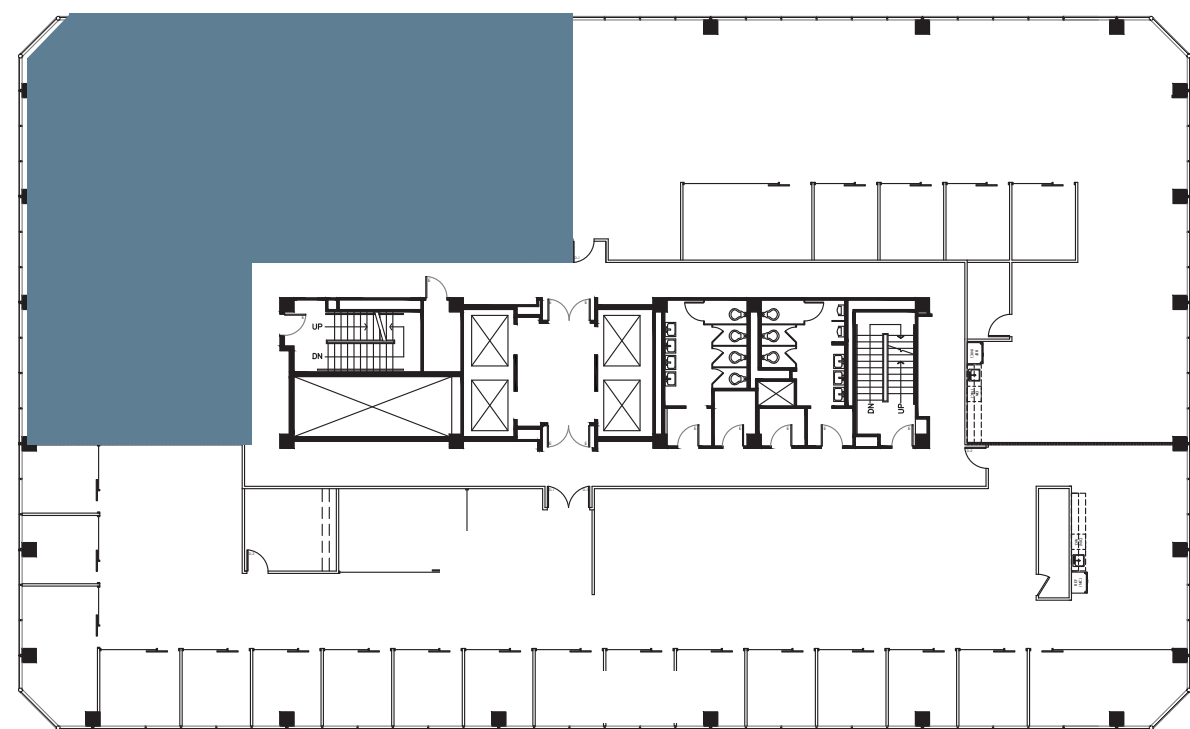

For leasing information please contact:  
USALEASING@ONNI.COM  
(213) 629-2041