

SUITE: 1425

RSF: 4,743



700 BRAND

AS-BUILT CONFIGURATION

PRIVATE OFFICES.....	4
RECEPTION.....	1
CONFERENCE ROOMS.....	1
KITCHEN.....	1
OPEN WORK AREA.....	+/- 36

Not to scale, furniture and appliances not included

KEY PLAN

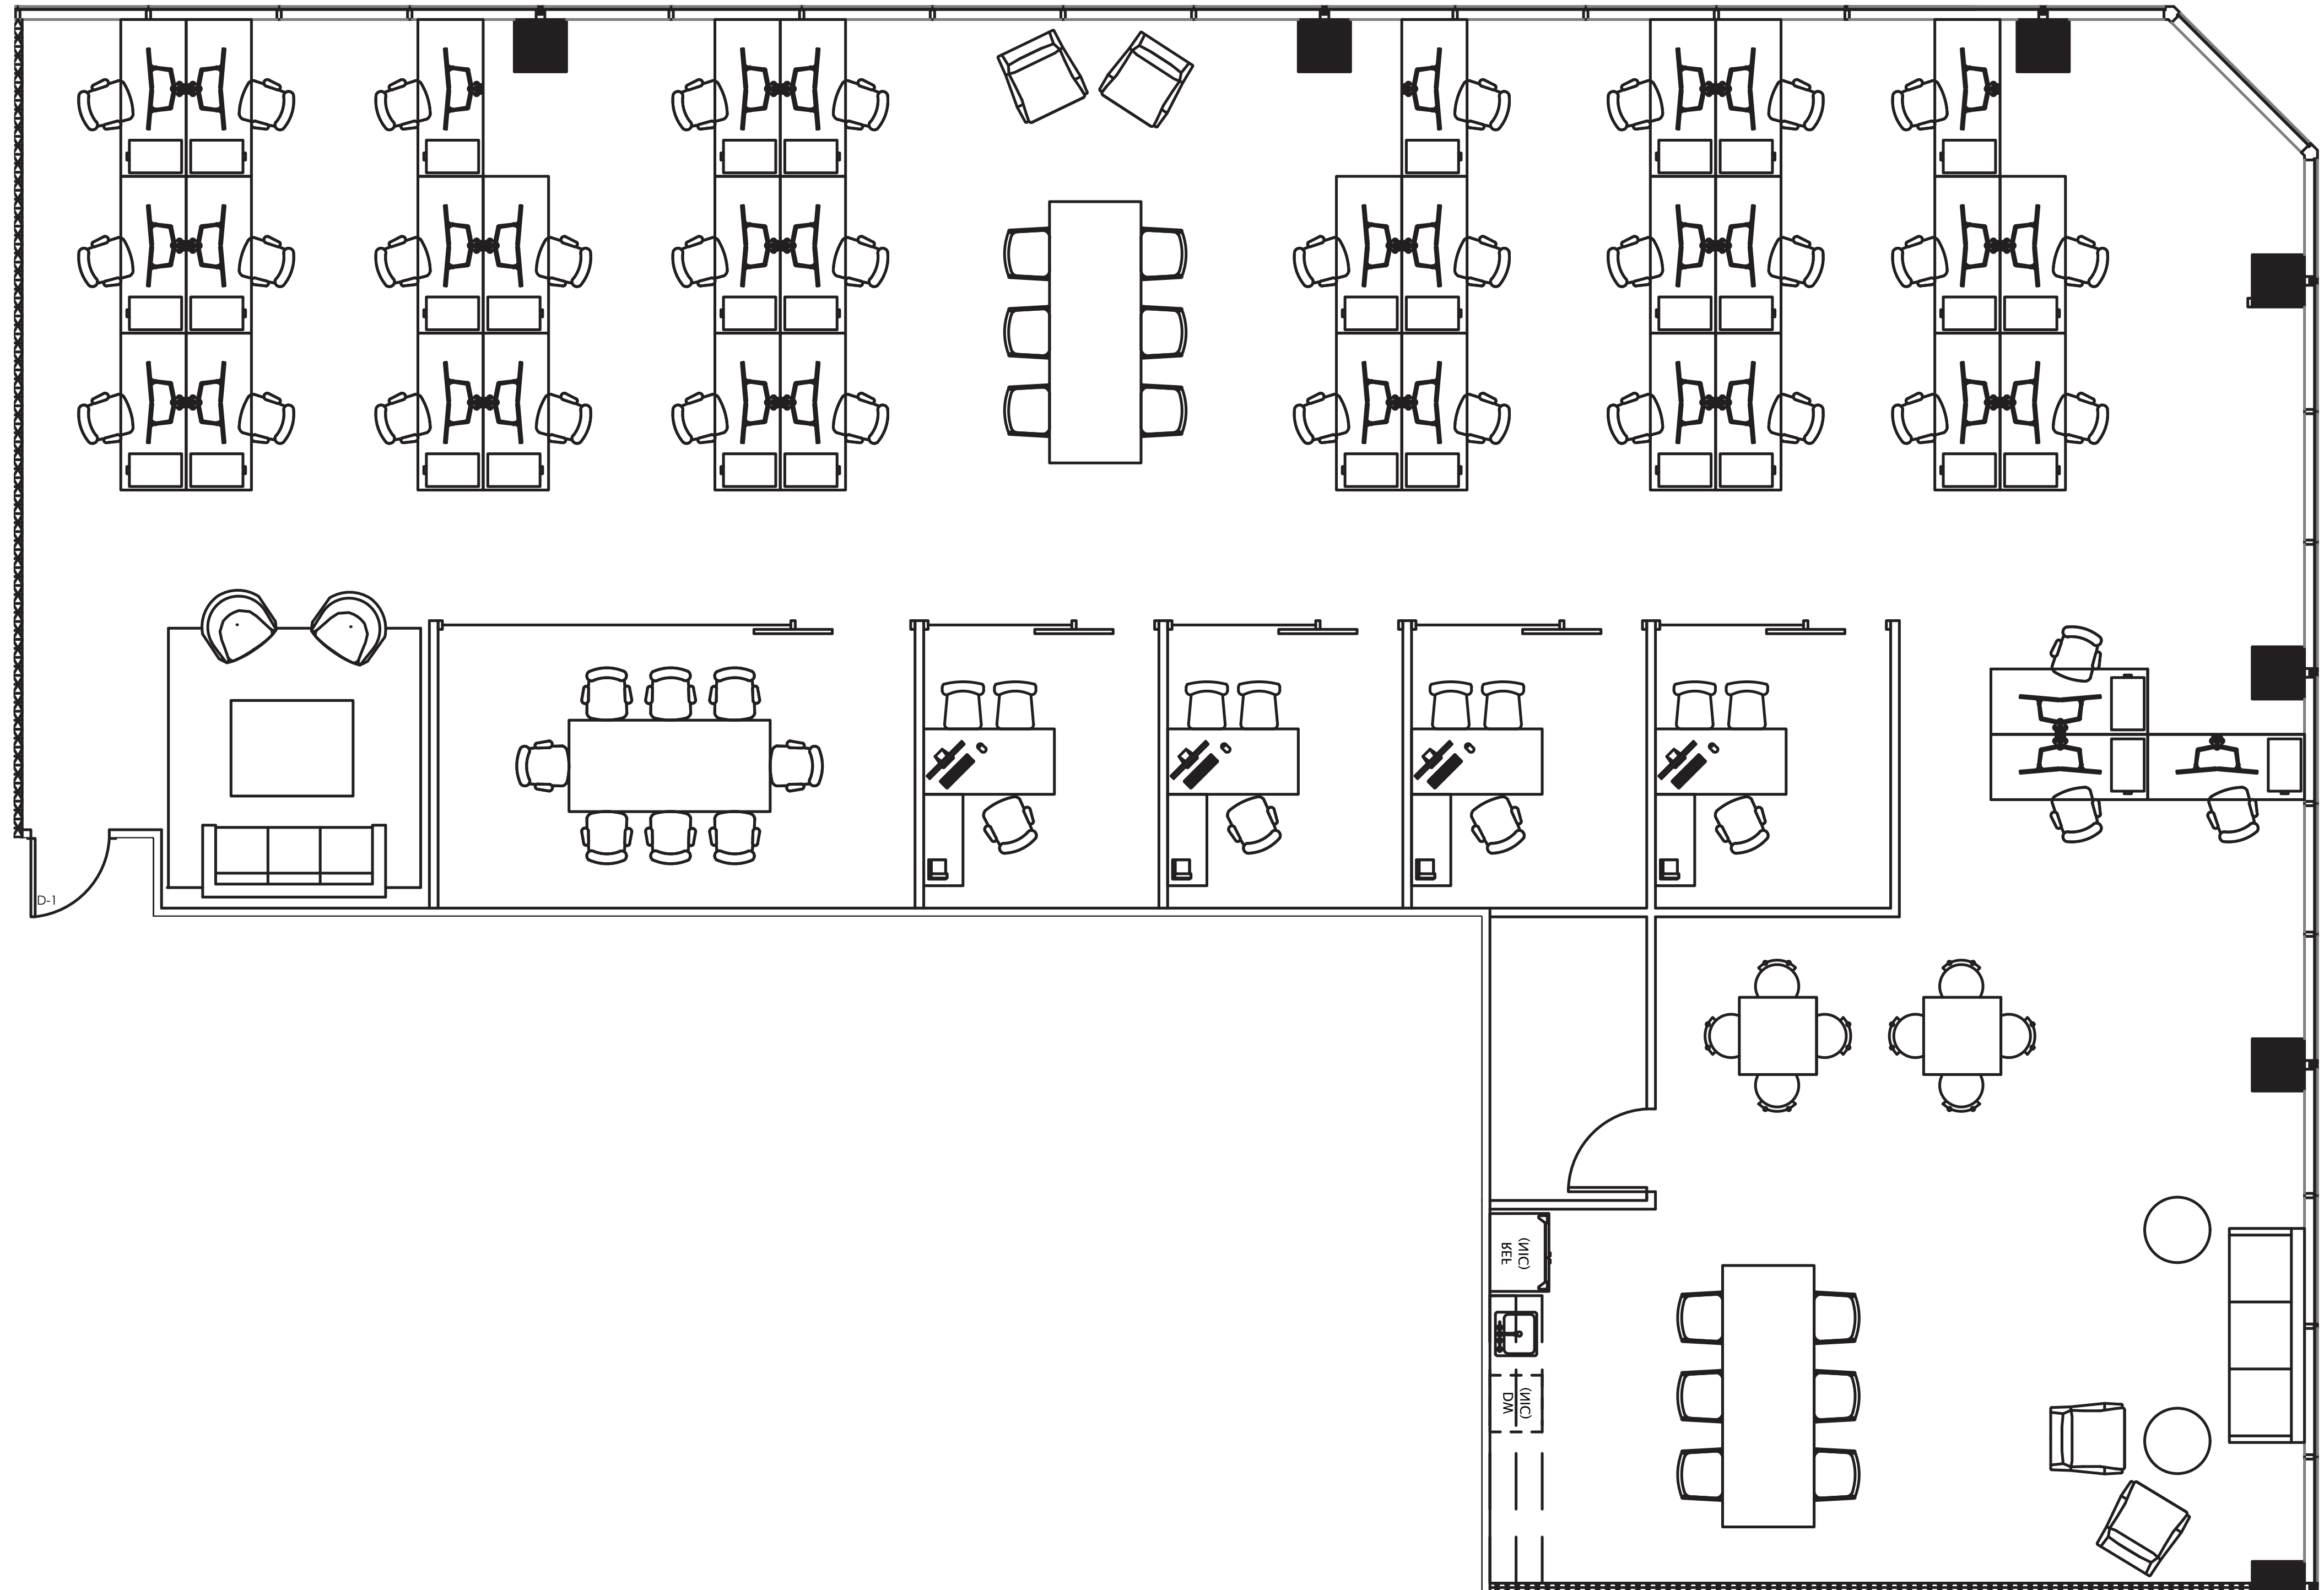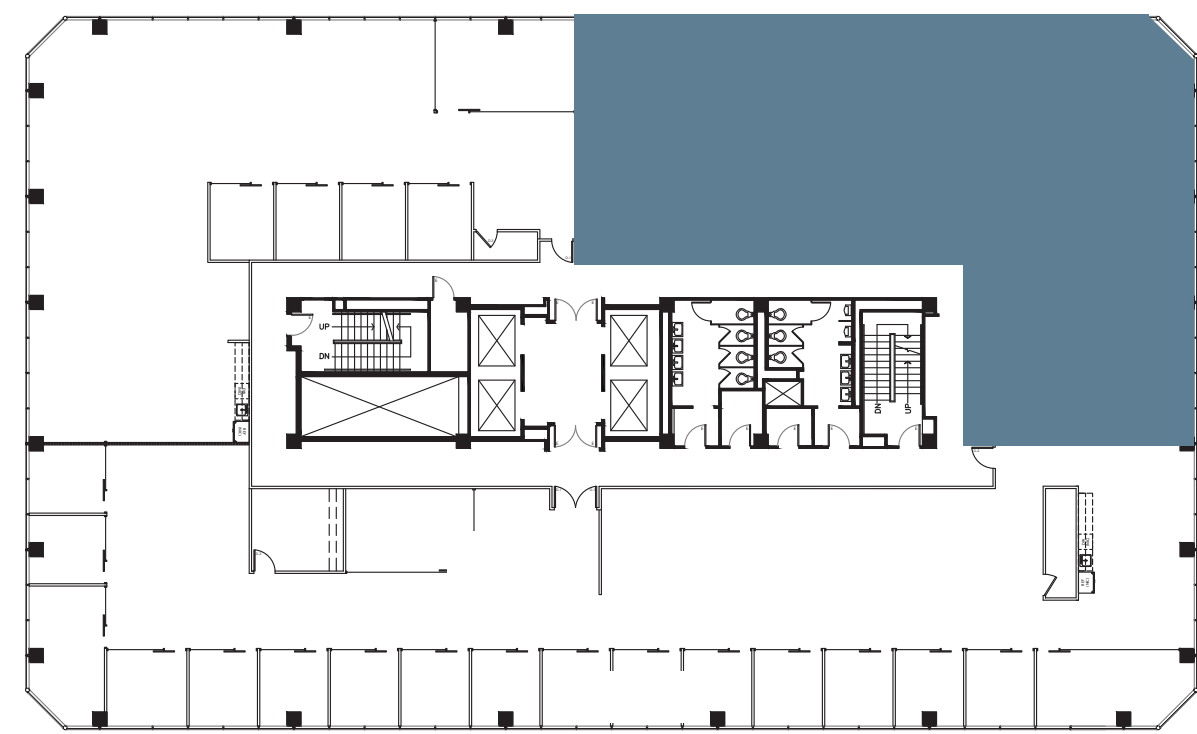

For leasing information please contact:
USALEASING@ONNI.COM
(213) 629-2041