
## SUITE: 220


### **AS-BUILT CONFIGURATION**

OFFICES	4
RECEPTION	1
CONFERENCE ROOMS	2
KITCHEN	1
OPEN WORK AREA1	12

Not to scale, furniture and appliances not included

#### KEY PLAN

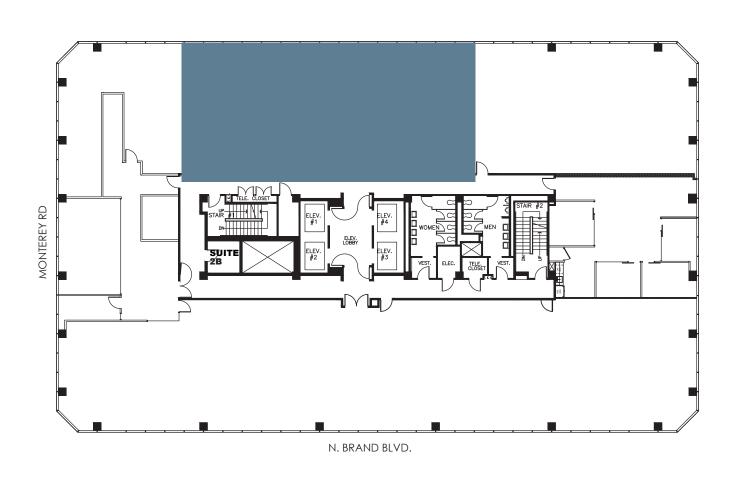

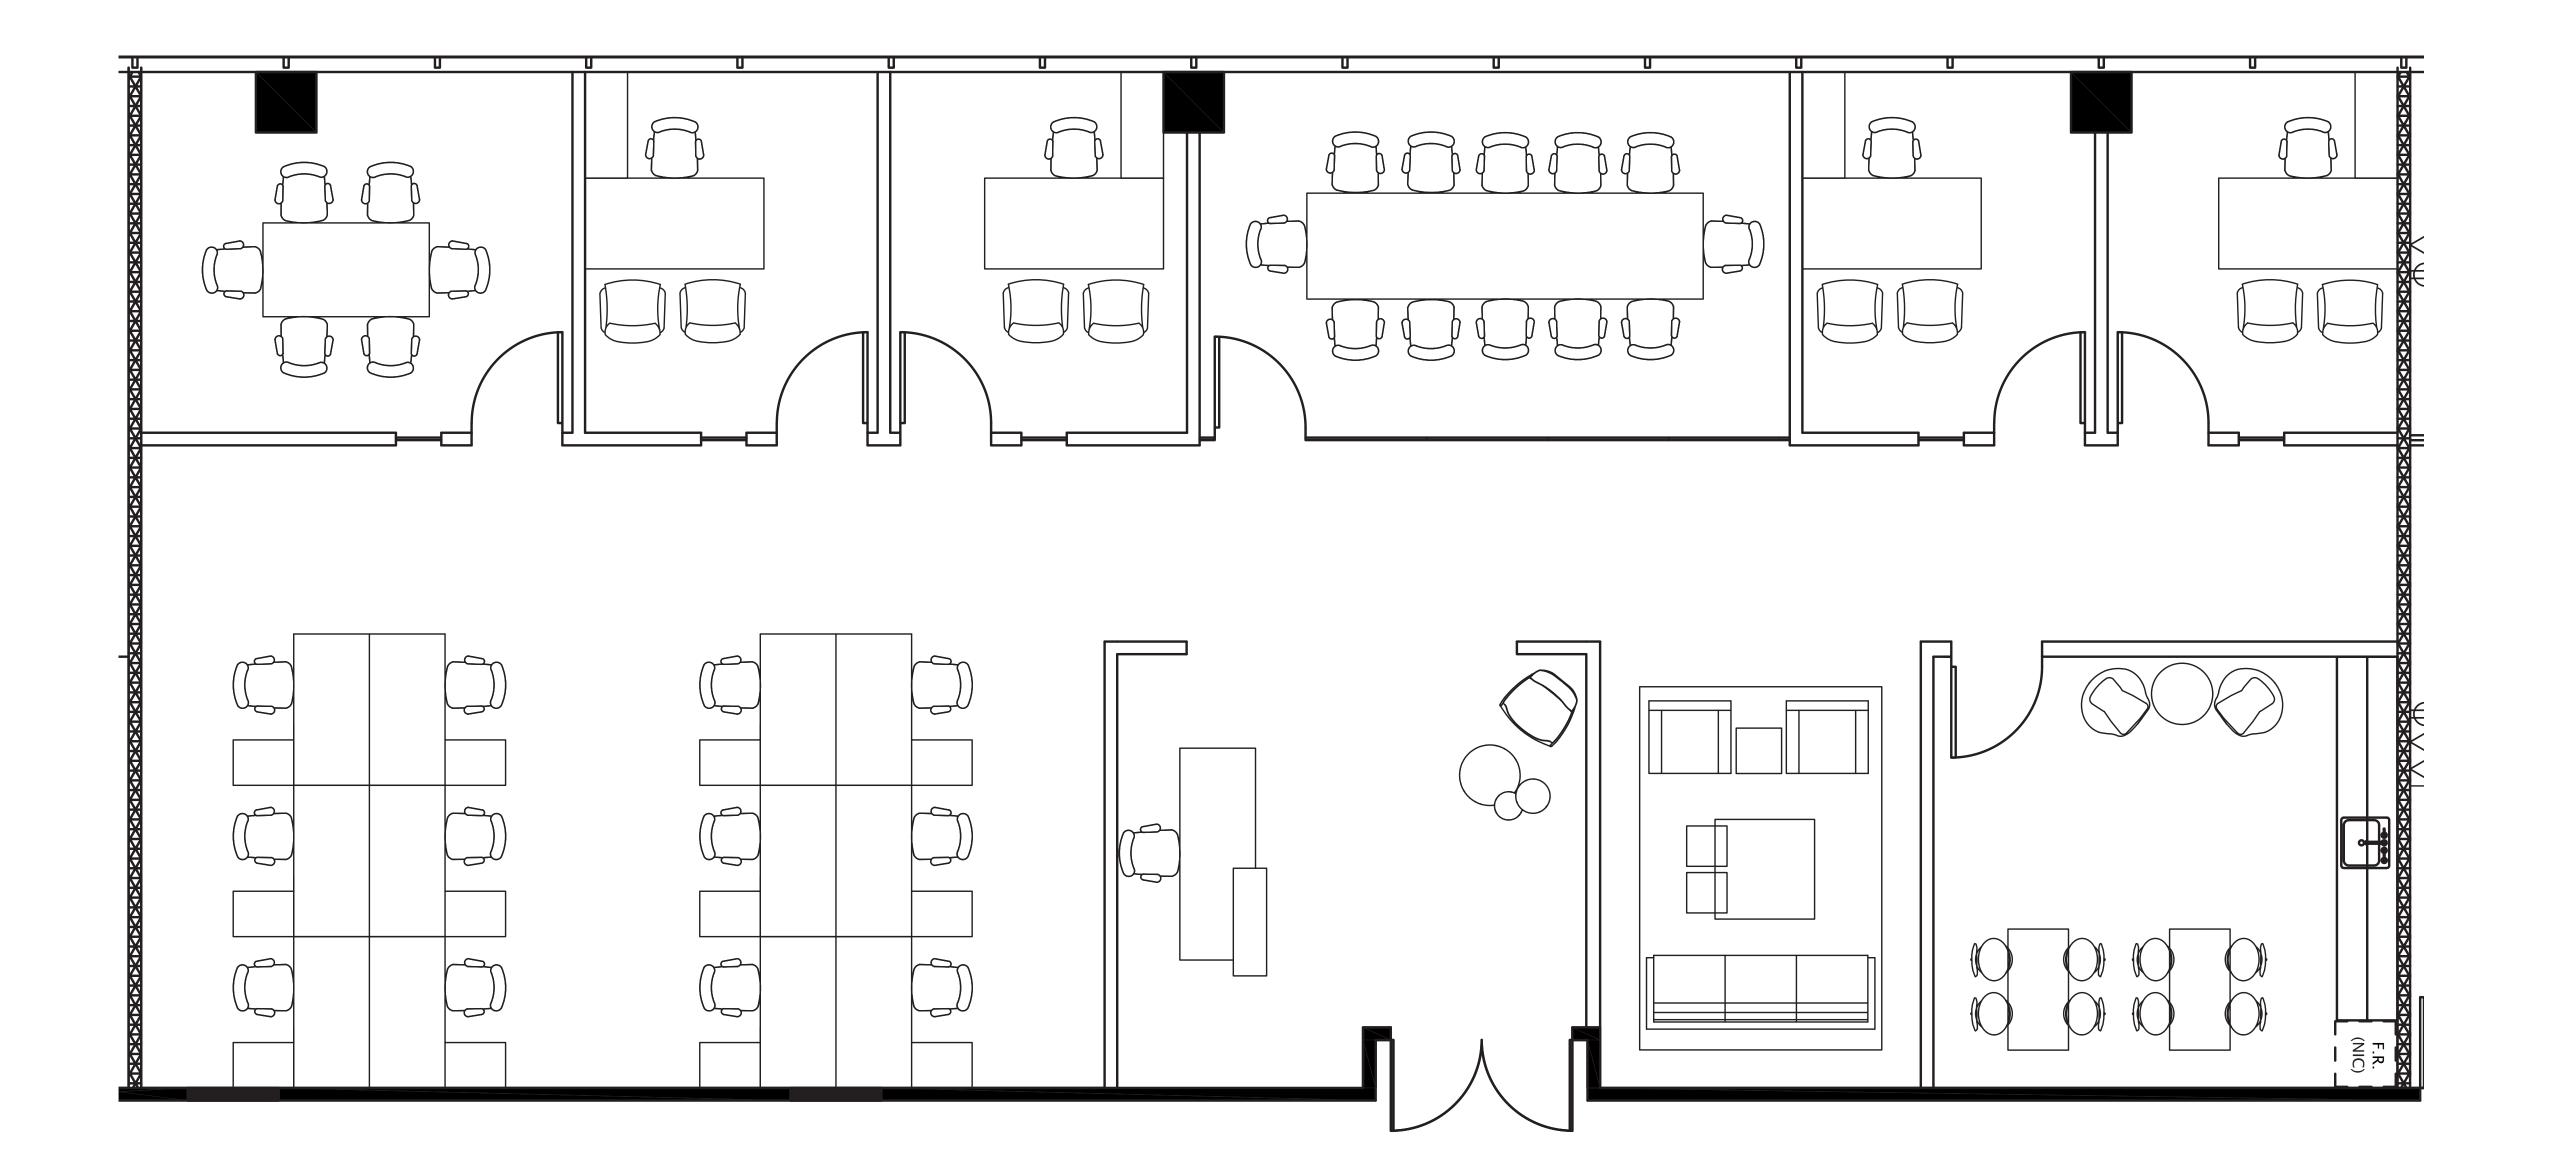

#### For leasing information please contact: USALEASING@ONNI.COM (213) 629-2041

## RSF: 3,112

# ZOOBRAND

