

SUITE: 440

RSF: 4,264



700BRAND

AS-BUILT CONFIGURATION

OFFICES.....	5
RECEPTION.....	1
CONFERENCE ROOMS.....	1
KITCHEN.....	1
OPEN WORK AREA.....	20

Not to scale, furniture and appliances not included

KEY PLAN

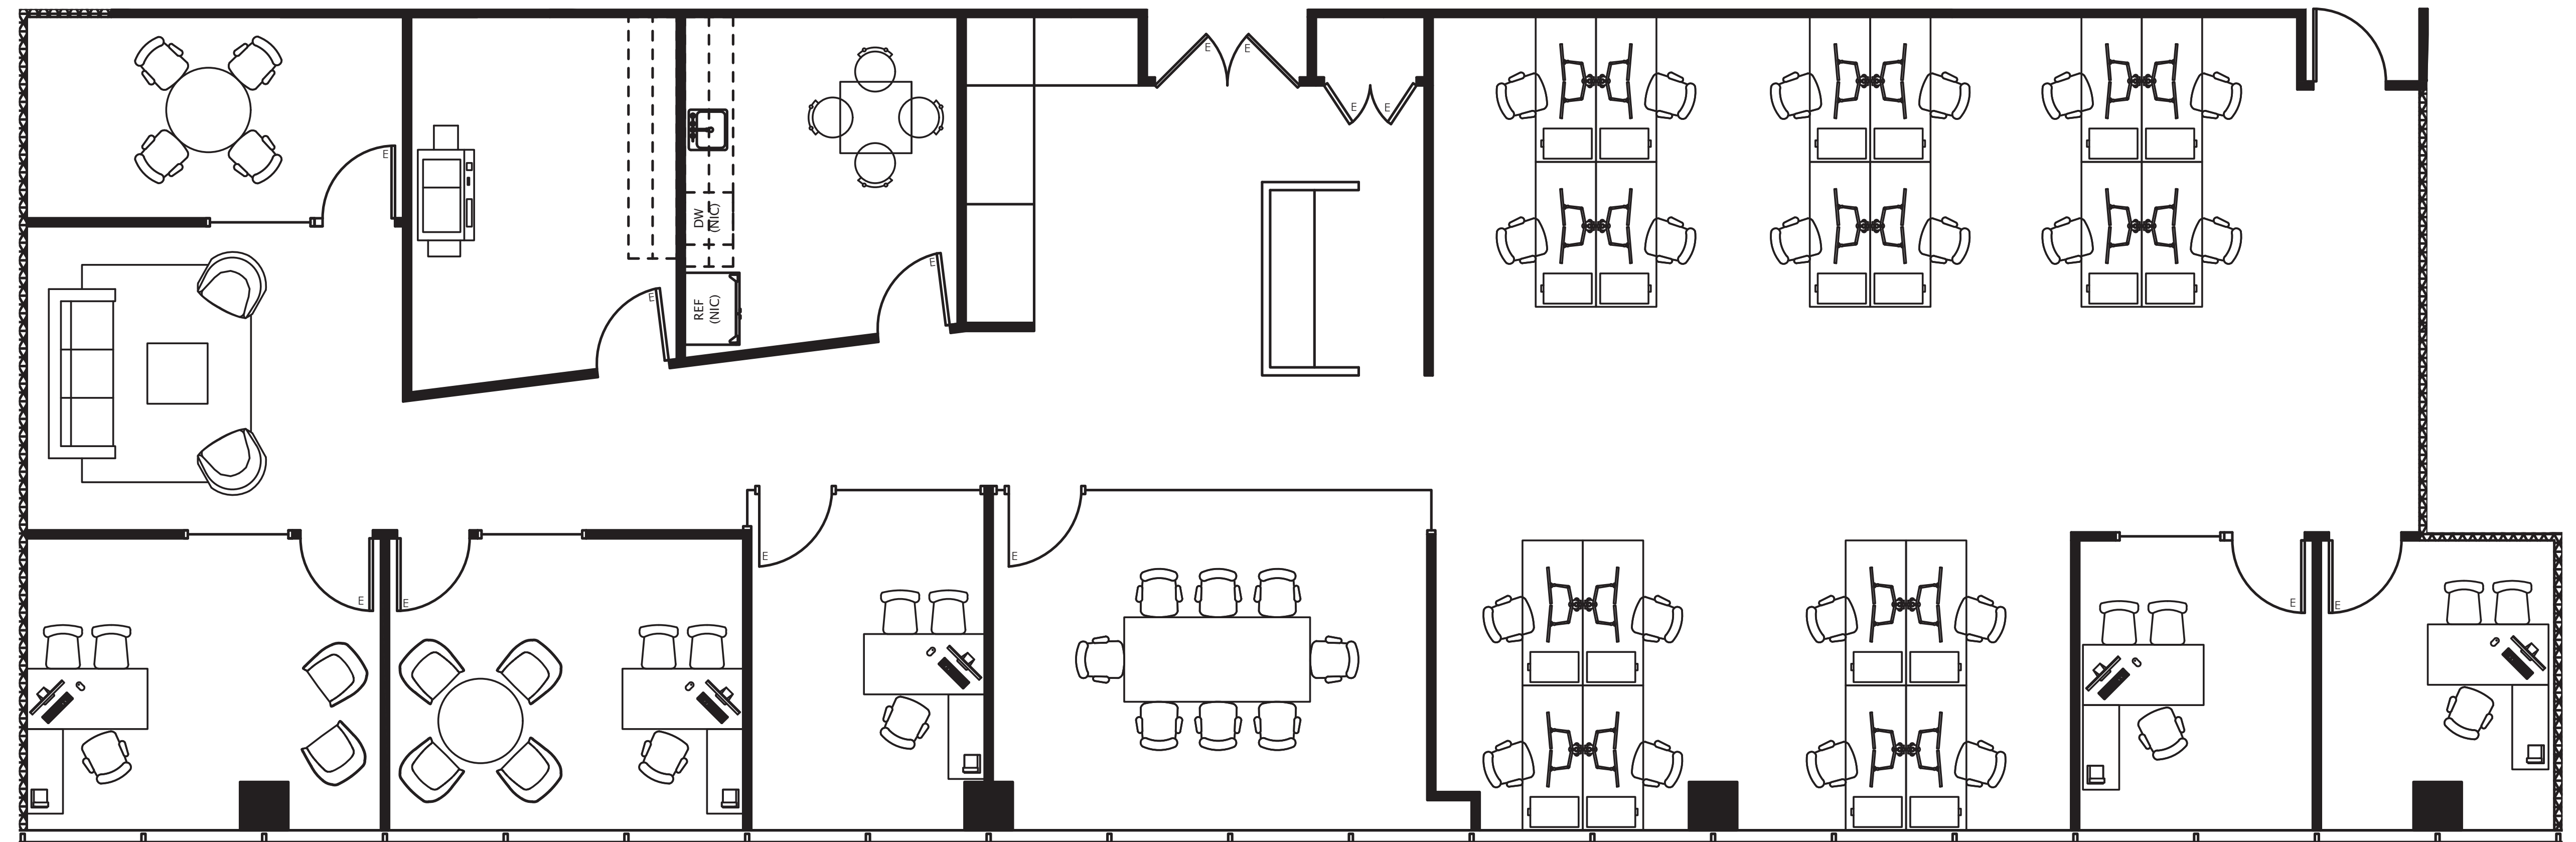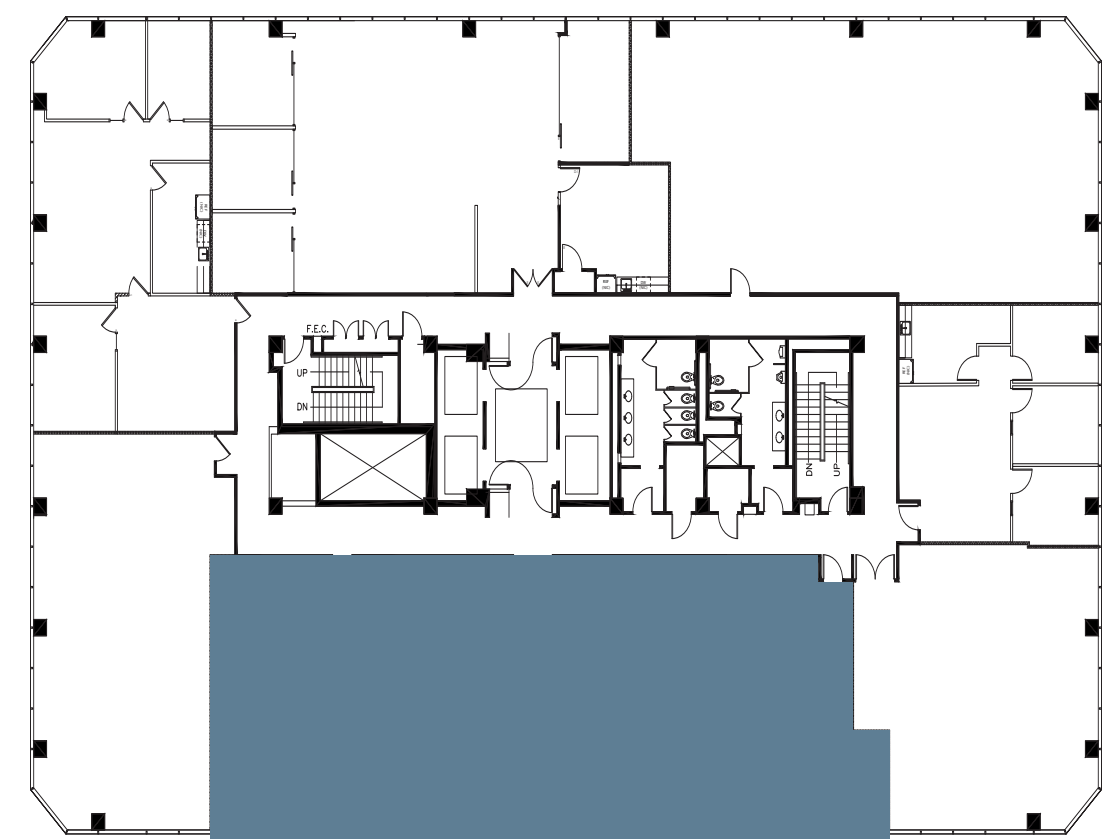

For leasing information please contact:
USALEASING@ONNI.COM
(213) 629-2041

