

SUITE: 400



RSF: 4,113

535BRAND

AS-BUILT CONFIGURATION

- OFFICES.....4
- RECEPTION.....1
- CONFERENCE ROOMS.....1
- KITCHEN/BREAKOUT1
- OPEN WORK AREA..... +/- 20

KEY PLAN

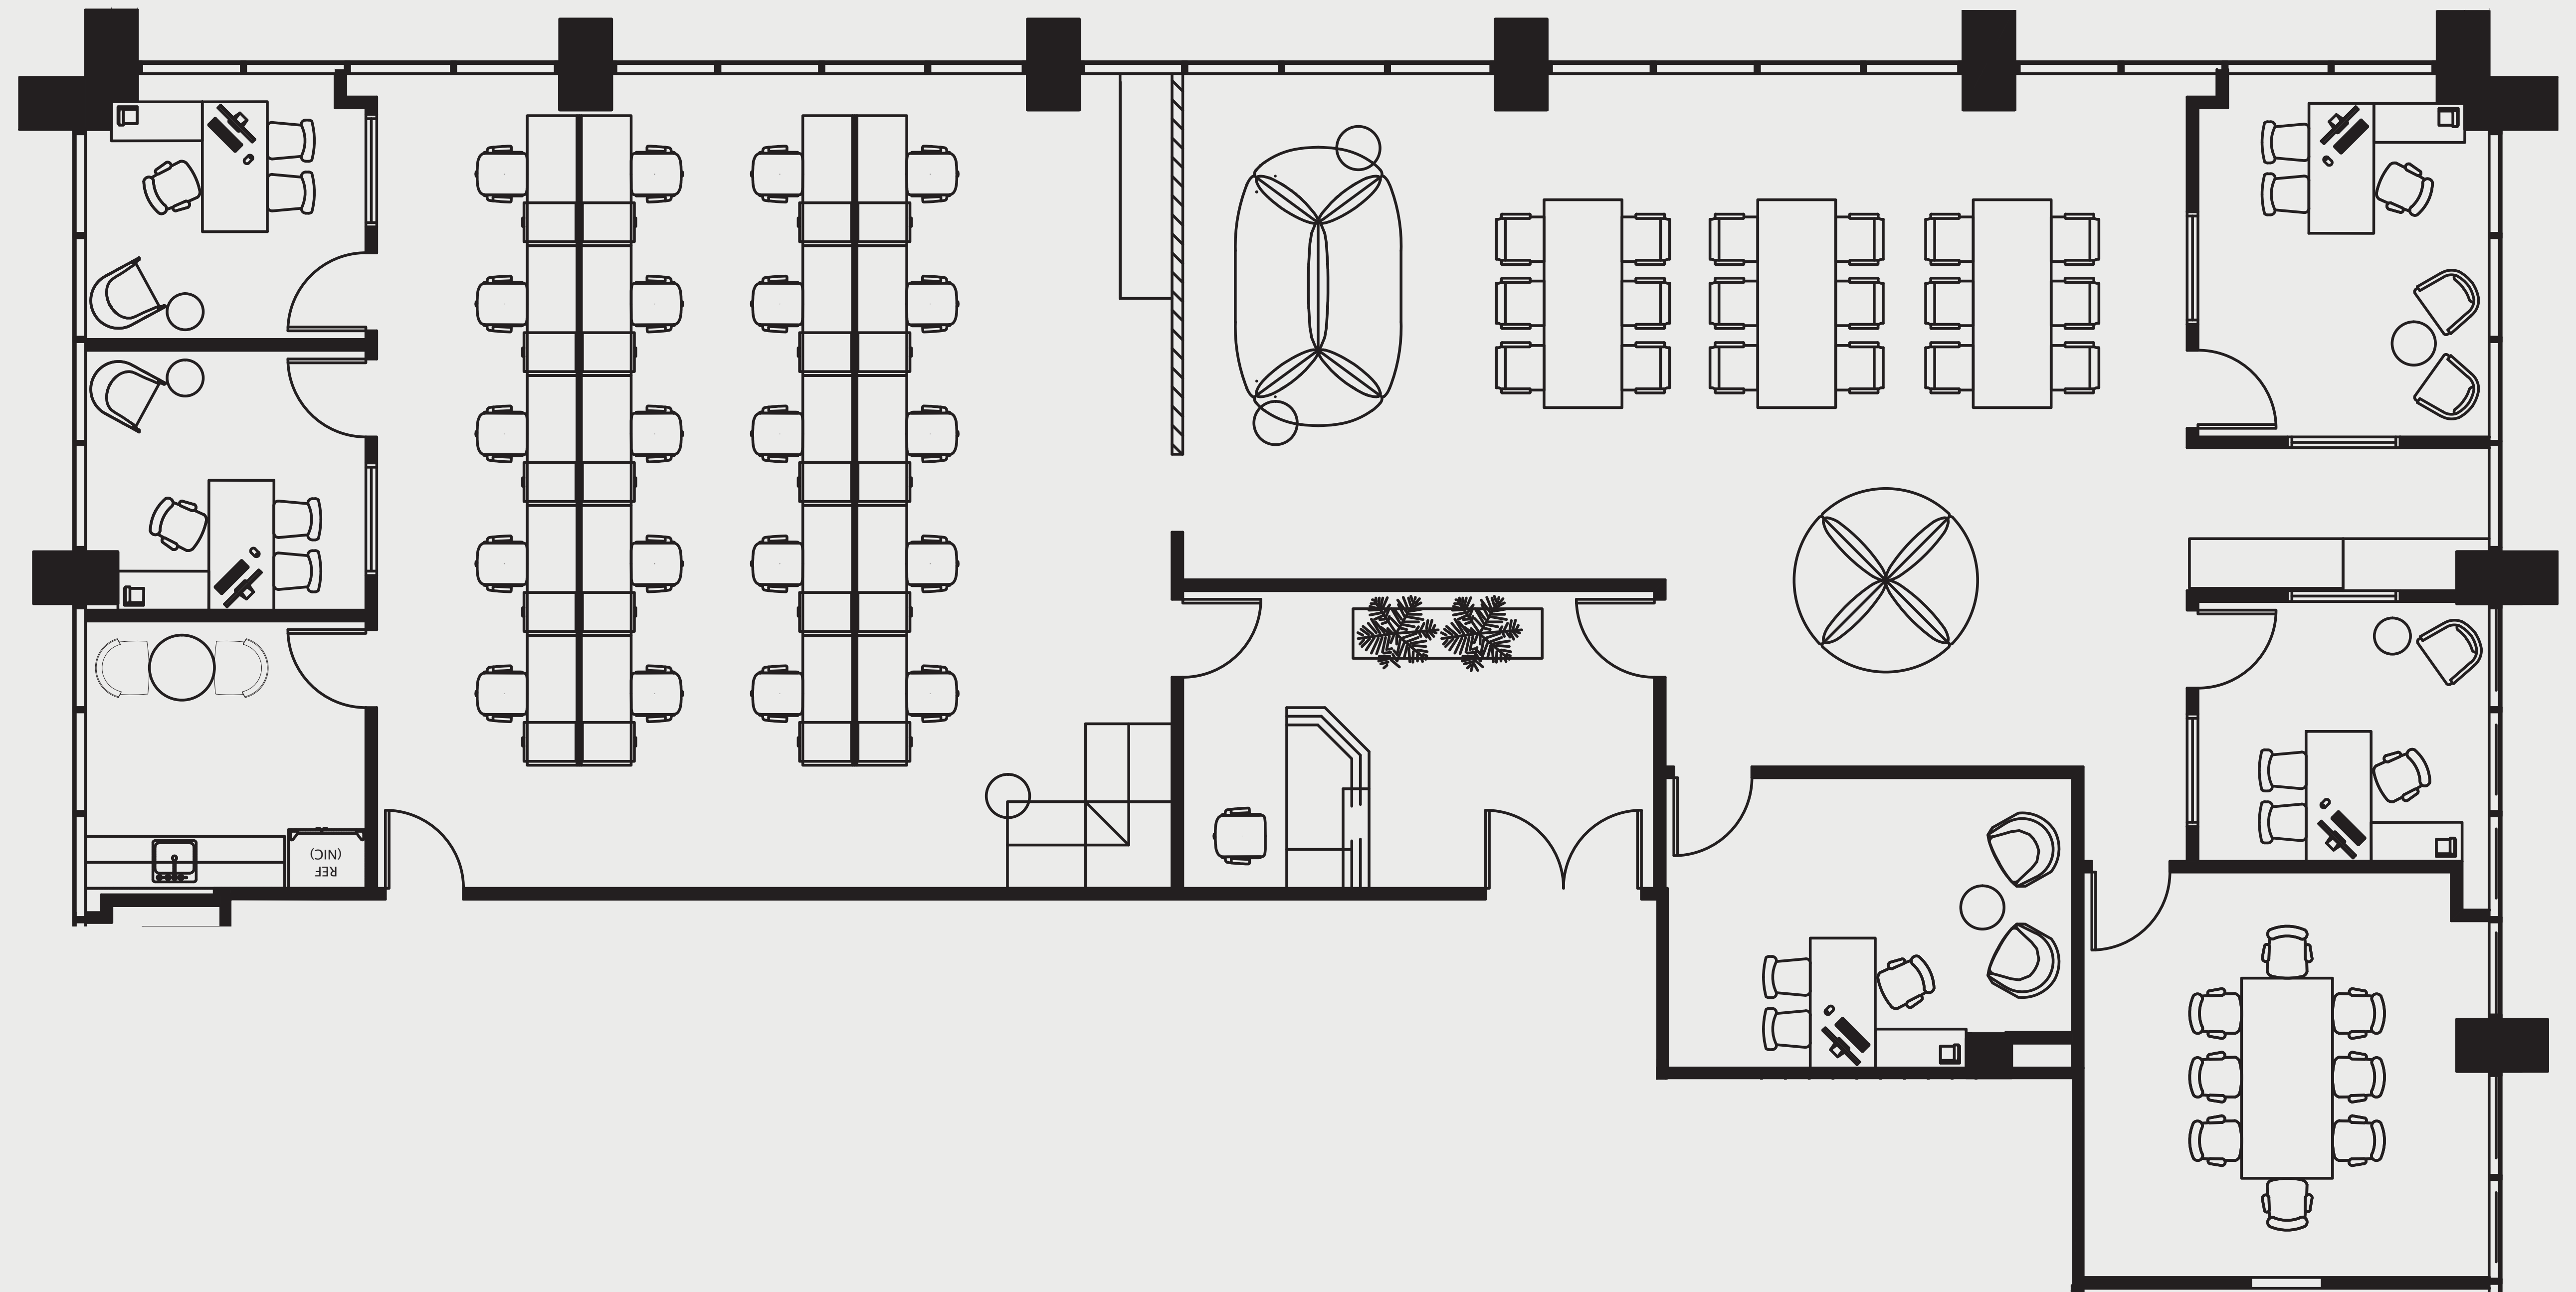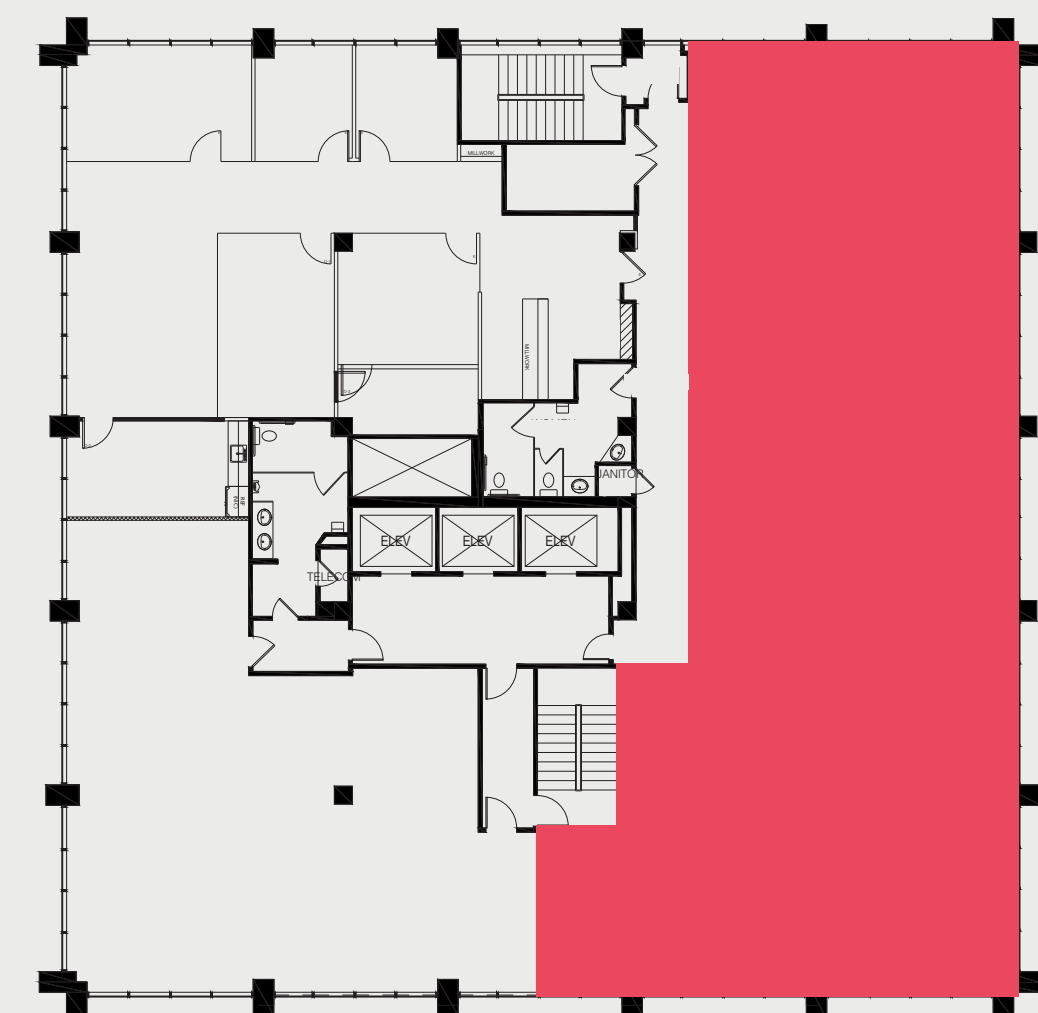

For leasing information please contact:

USALEASING@ONNI.COM
(213) 629-2041

