


SUITE: 510

RSF: 2,772


535 BRAND

AS-BUILT CONFIGURATION

- OFFICES..... 4
- RECEPTION..... 1
- CONFERENCE ROOMS..... 2
- KITCHEN/BREAKOUT ..... 1
- OPEN WORK AREA..... +/- 11

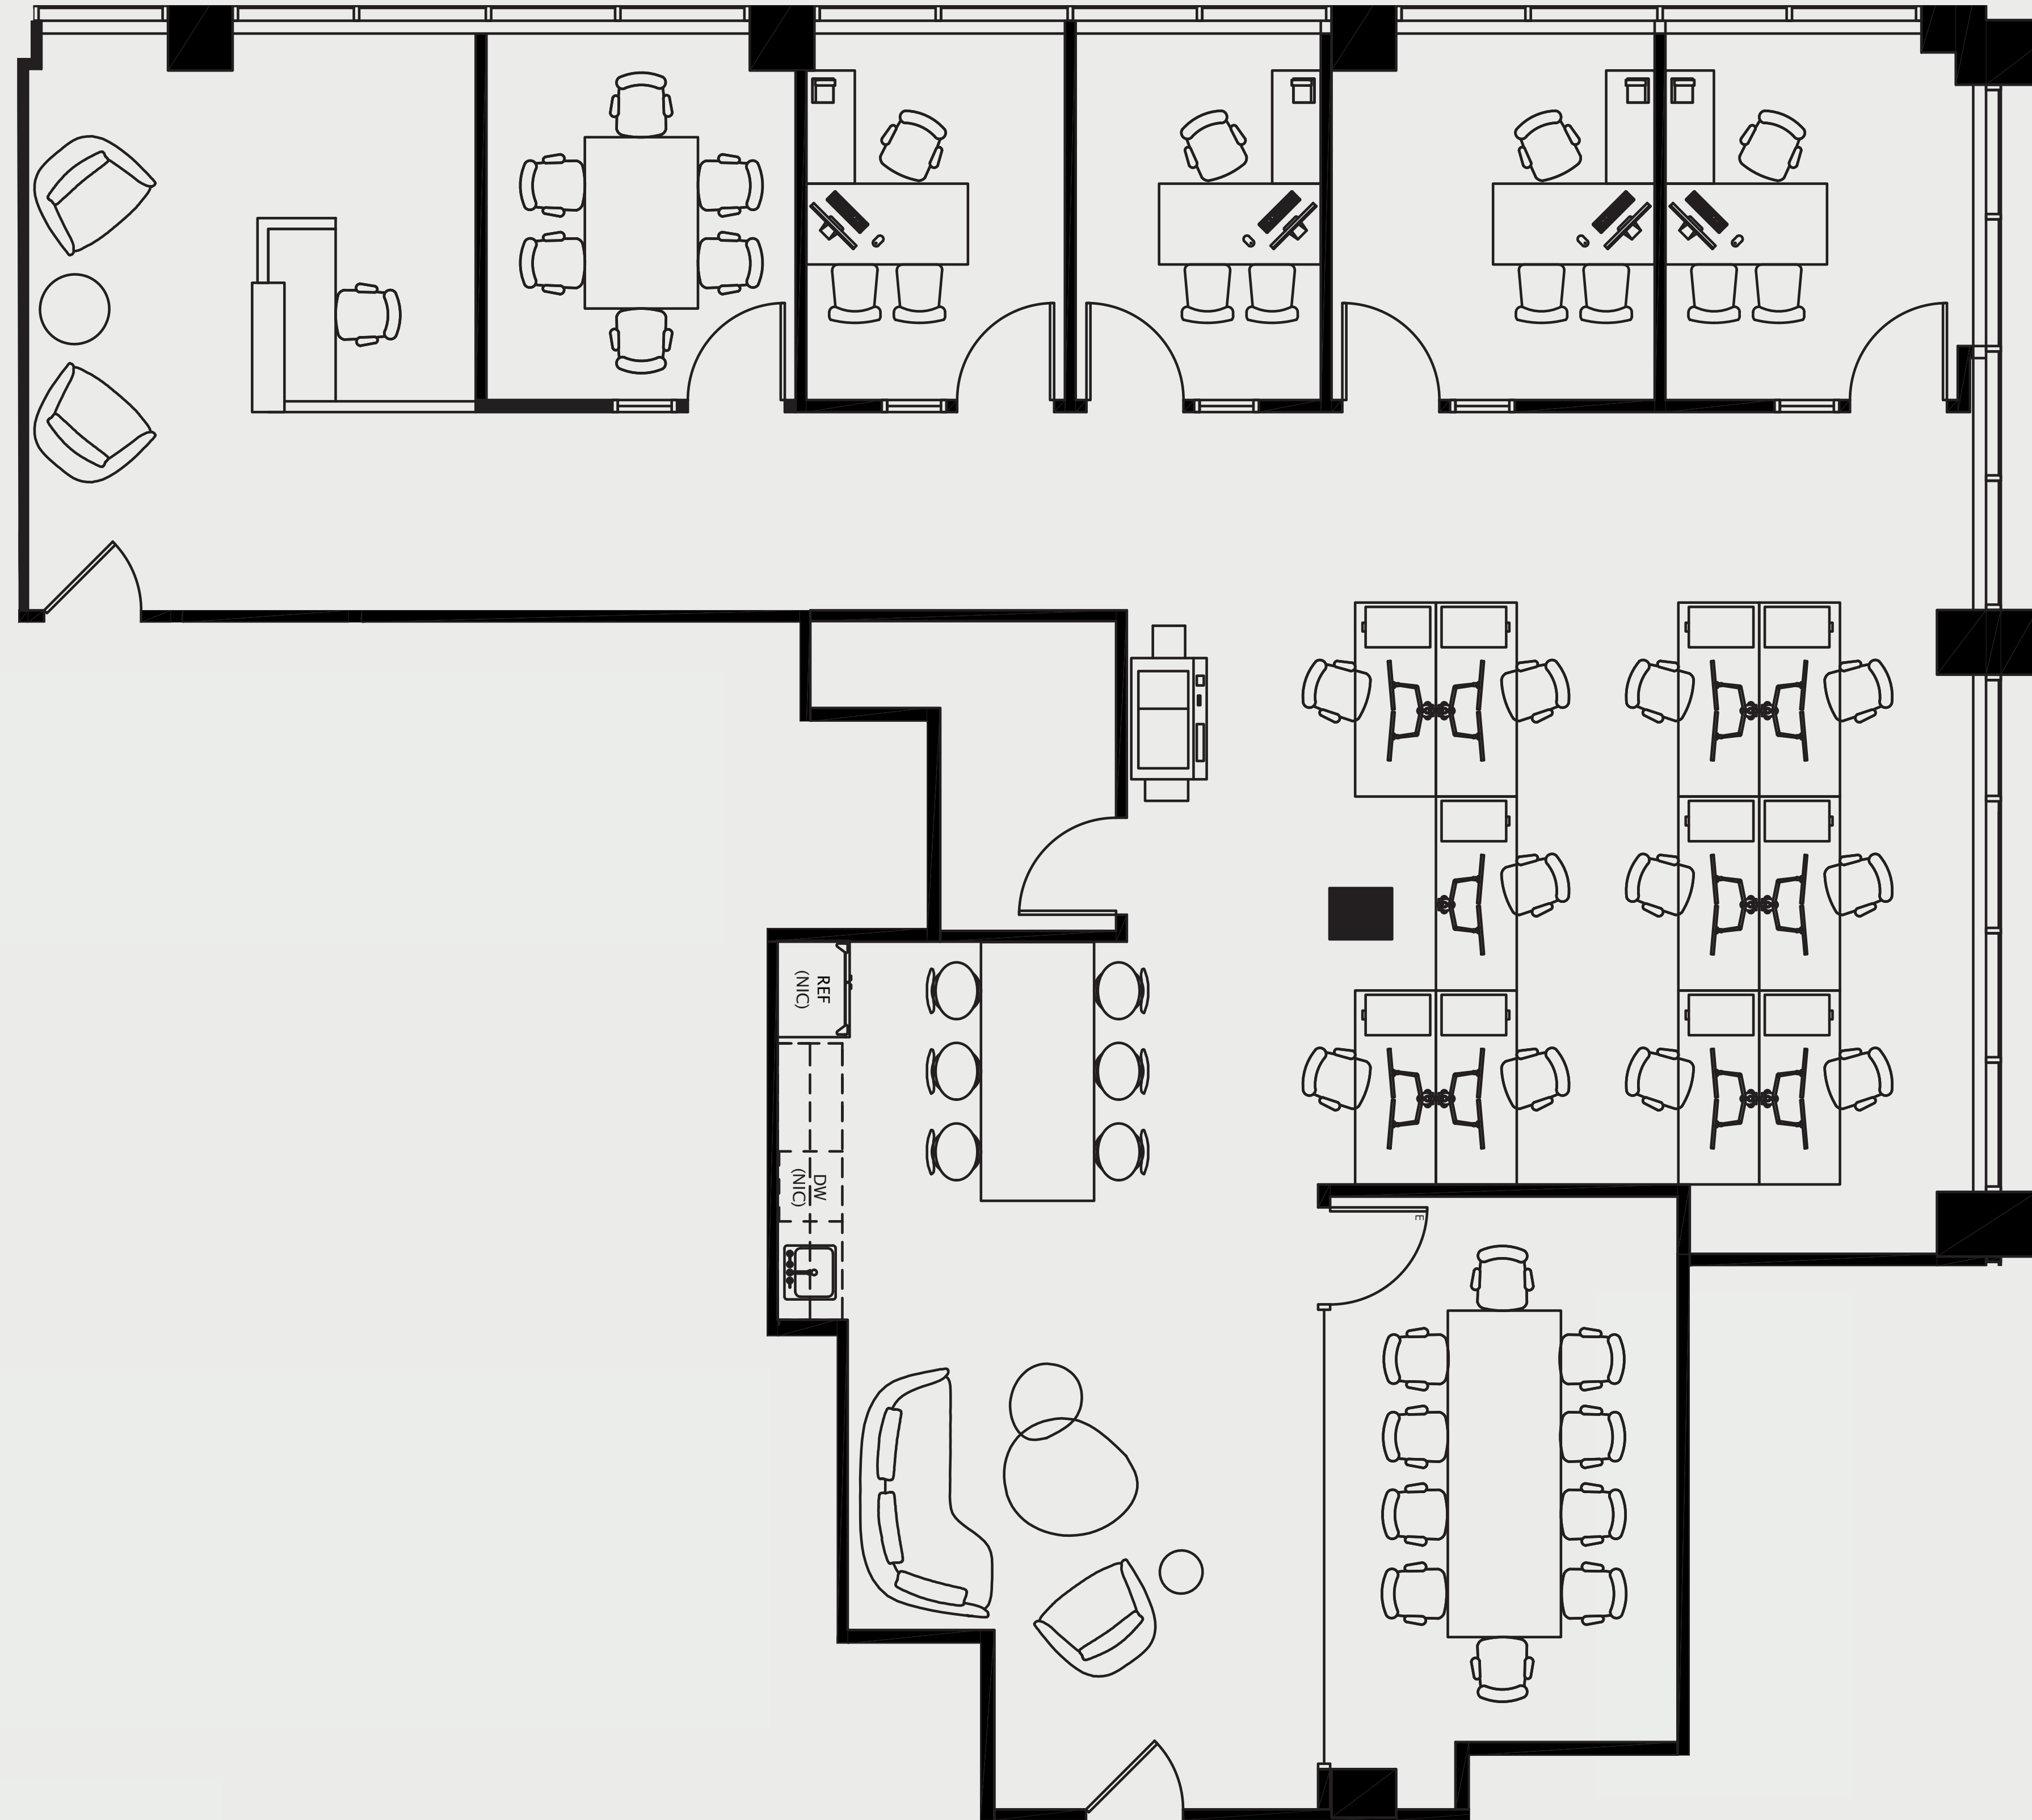

KEY PLAN

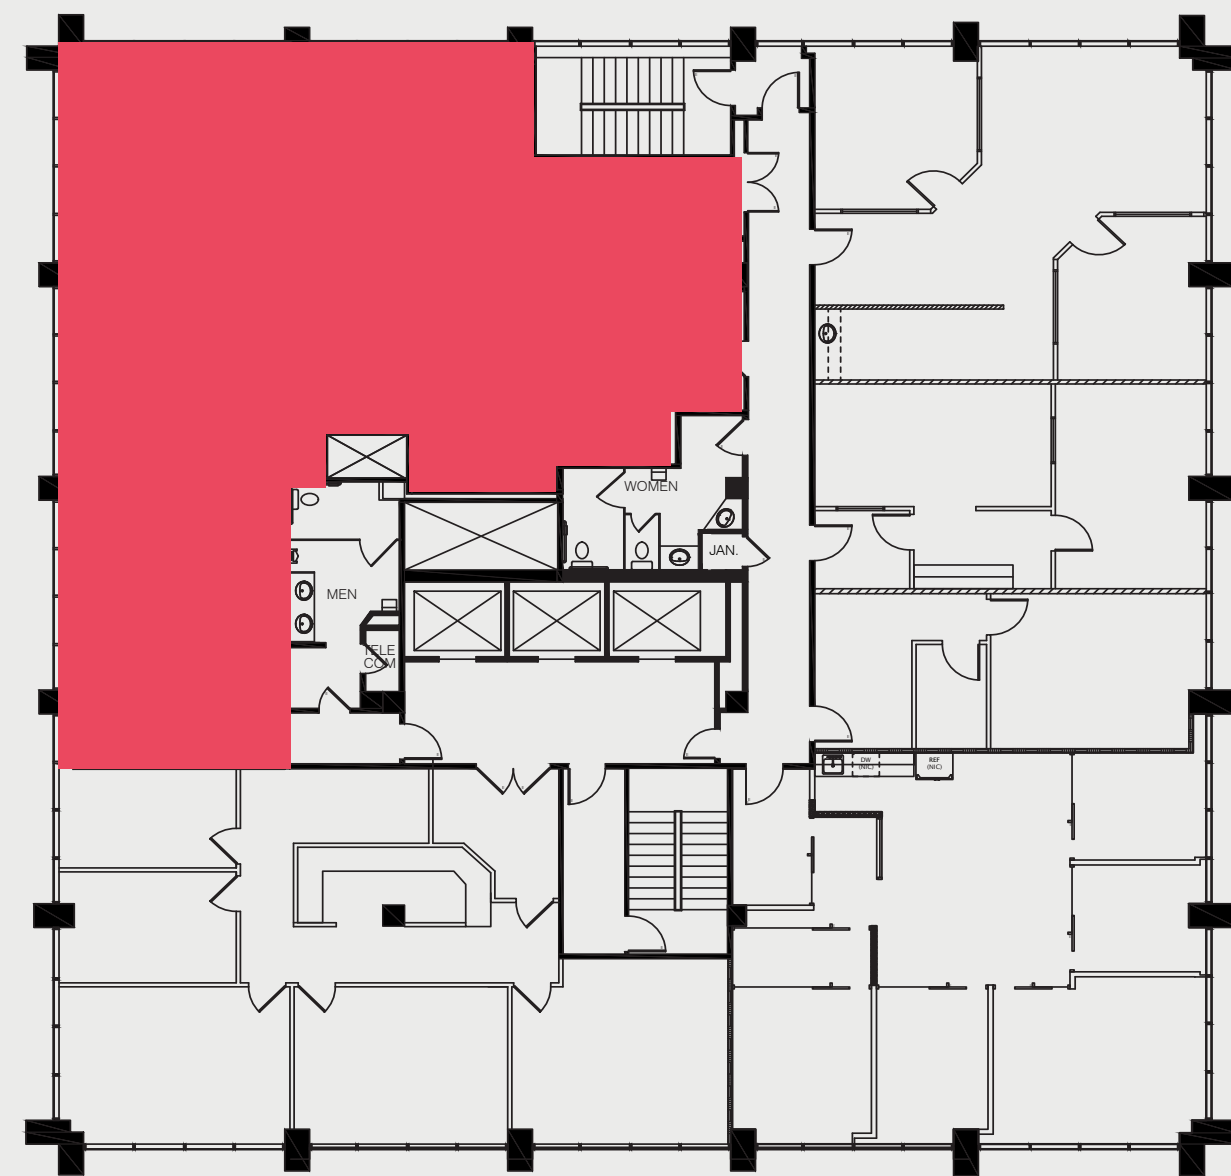

For leasing information please contact:

USALEASING@ONNI.COM  
(213) 629-2041