

SUITE: 705



RSF: 2,445

535 BRAND

AS-BUILT CONFIGURATION

- OFFICES.....3
- RECEPTION.....1
- CONFERENCE ROOMS.....2
- KITCHEN/BREAKOUT1

KEY PLAN

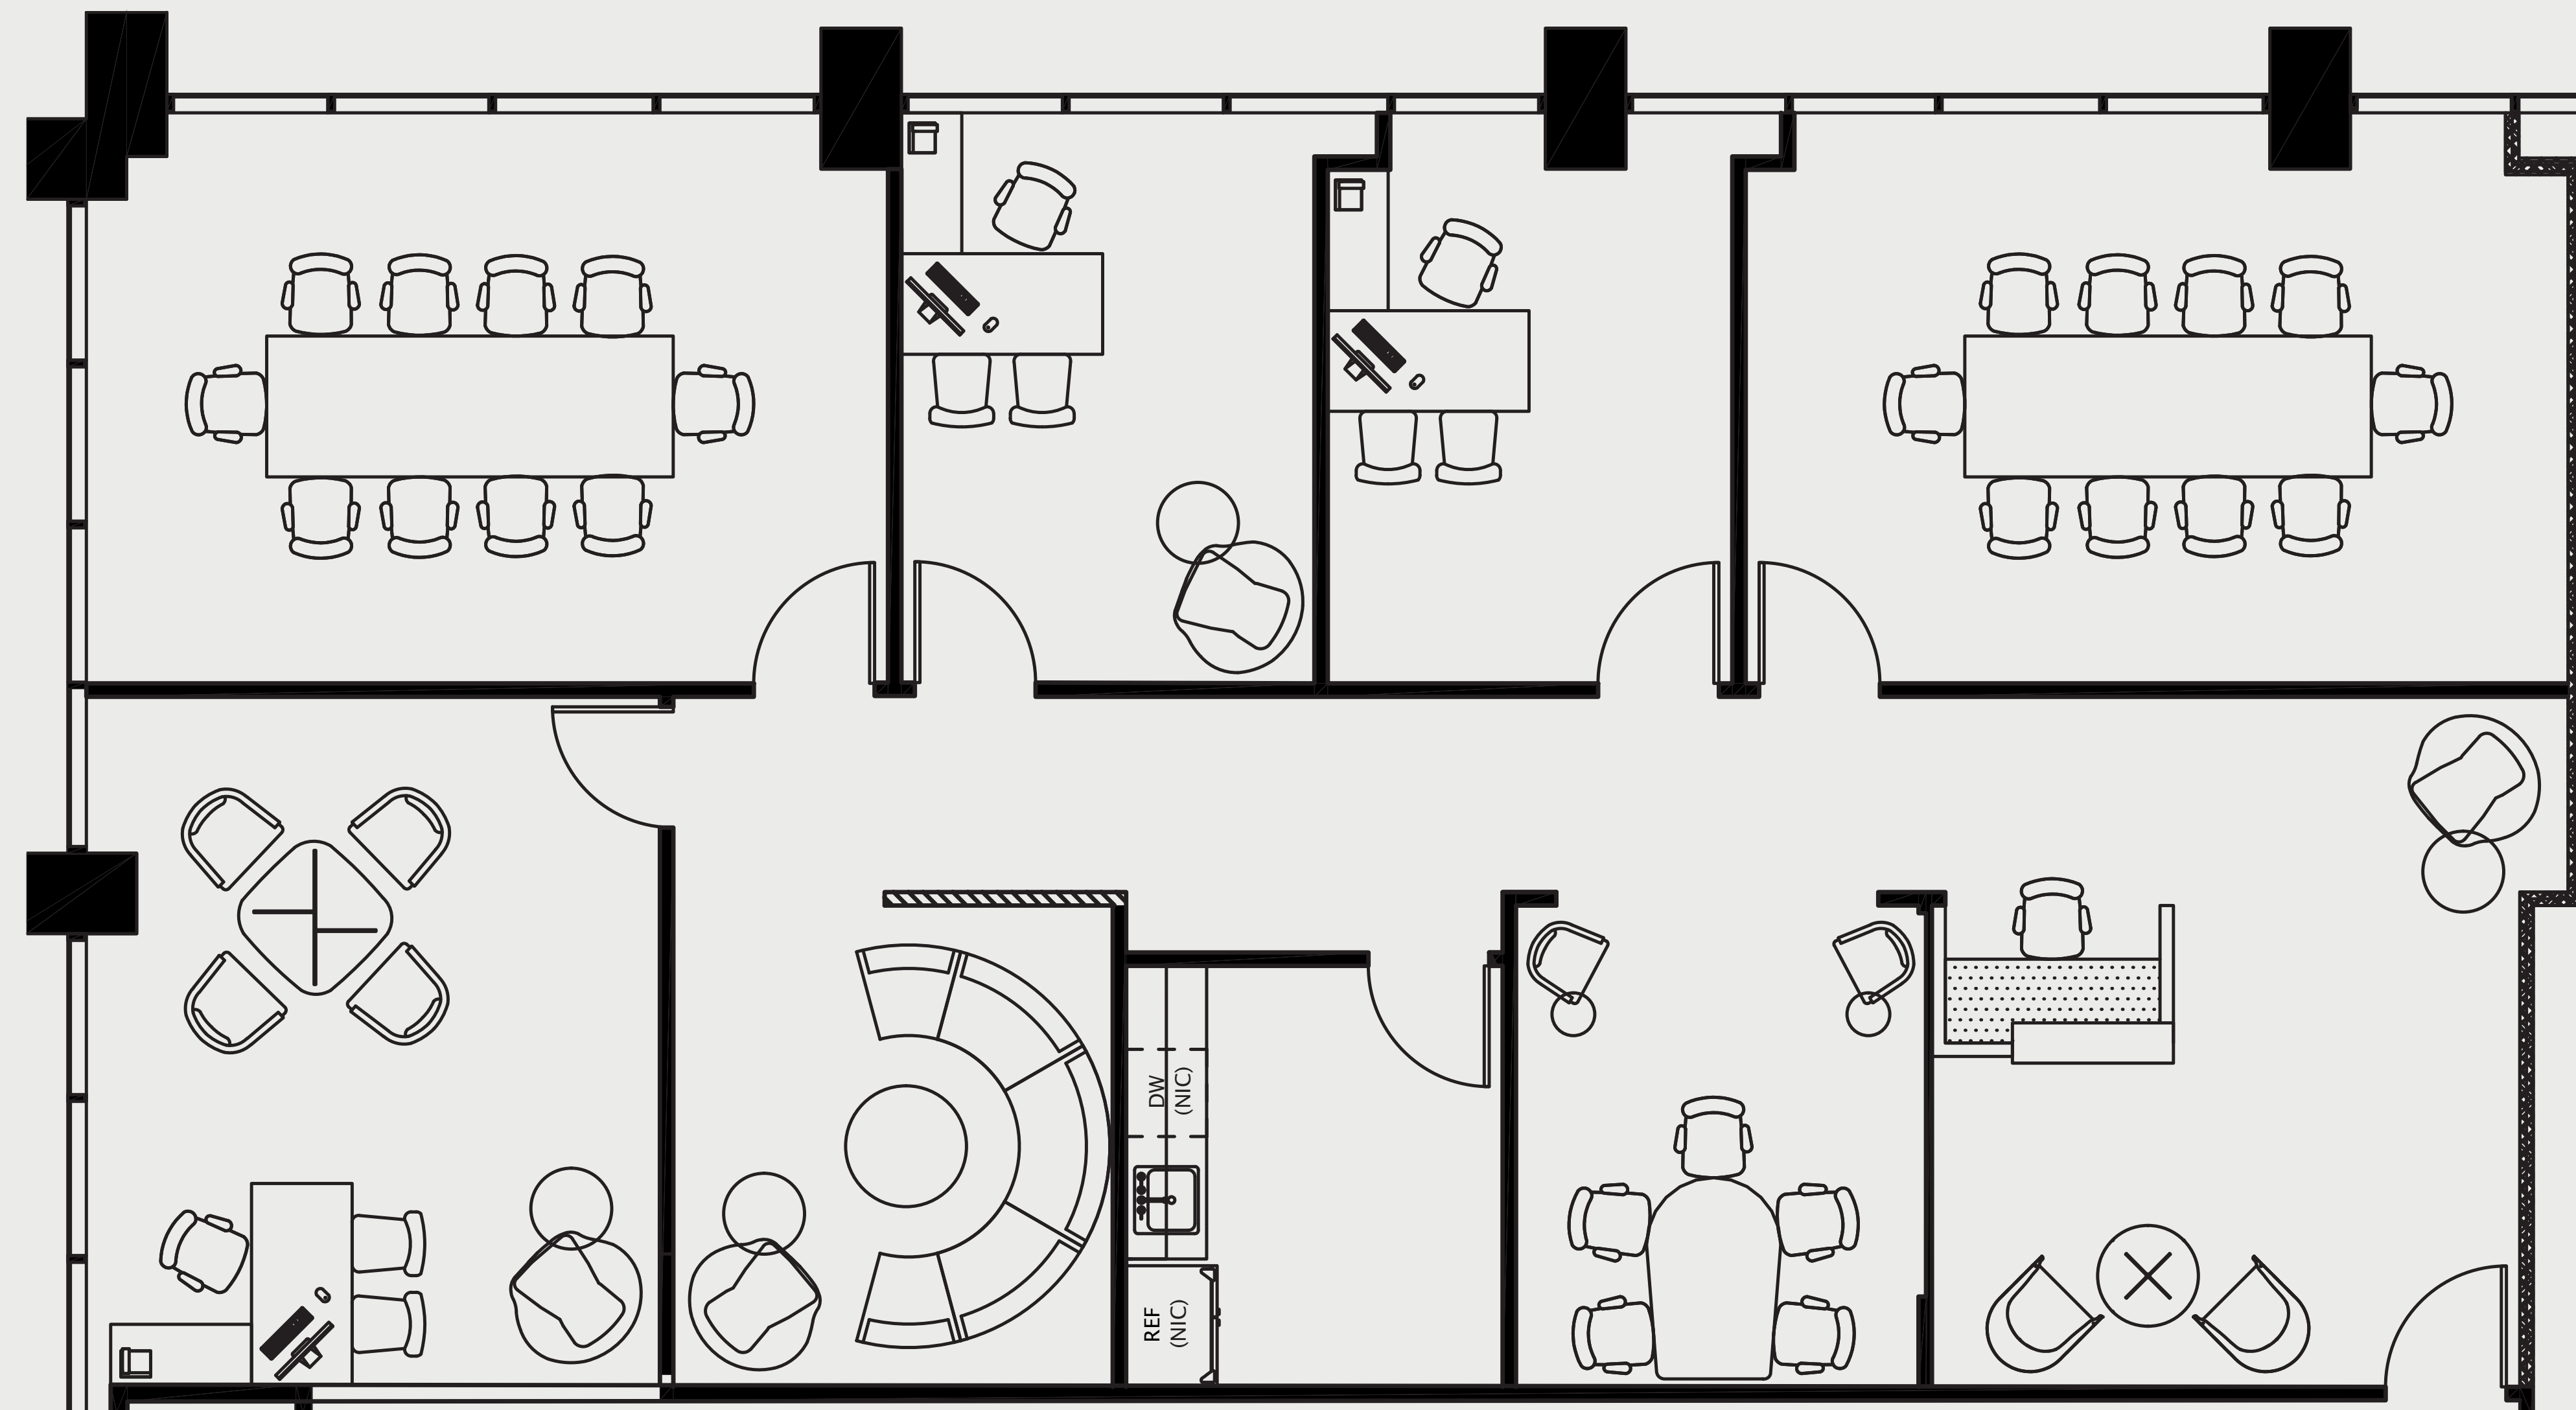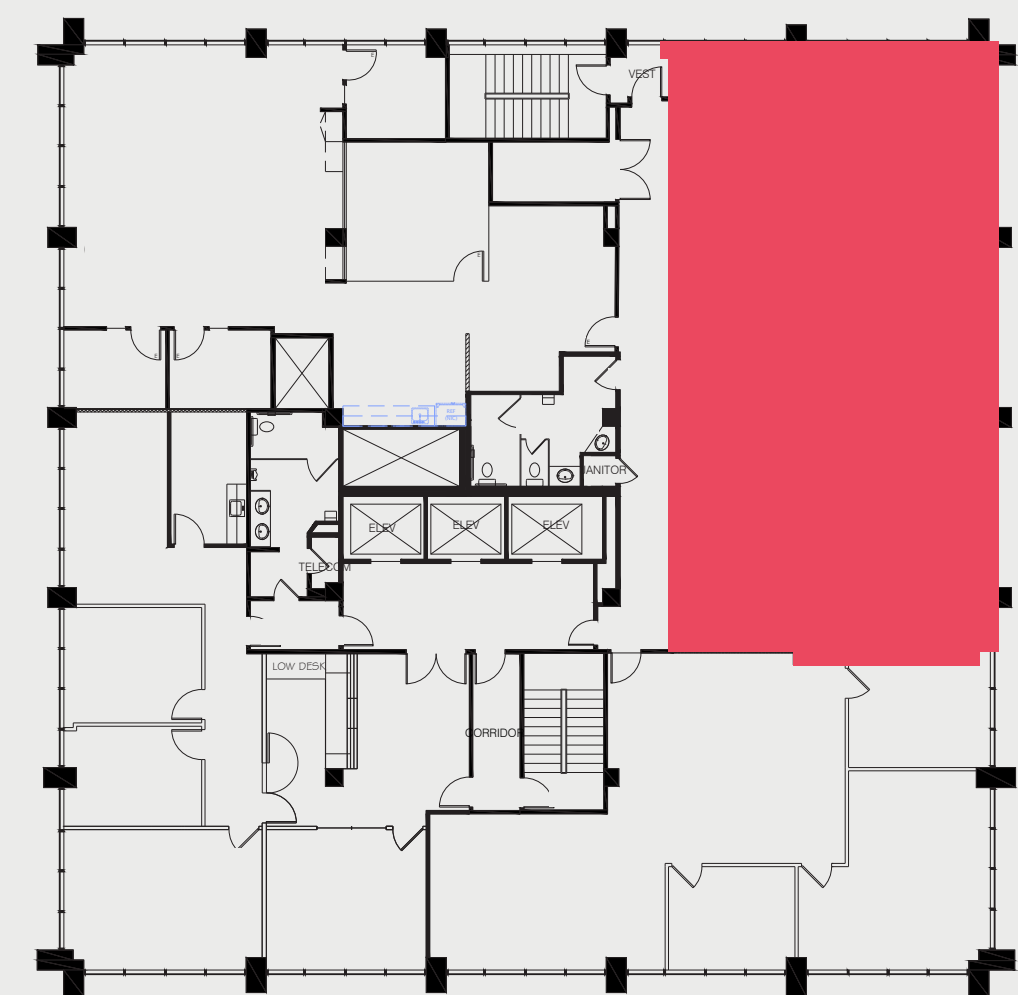

For leasing information please contact:

USALEASING@ONNI.COM
(213) 629-2041

