

SUITE: 1400

RSF: 16,484



700 BRAND

AS-BUILT CONFIGURATION

PRIVATE OFFICES.....	12
RECEPTION.....	1
CONFERENCE ROOMS.....	5
KITCHEN.....	1
OPEN WORK AREA.....	138

*Not to scale, furniture and appliances not included*

KEY PLAN

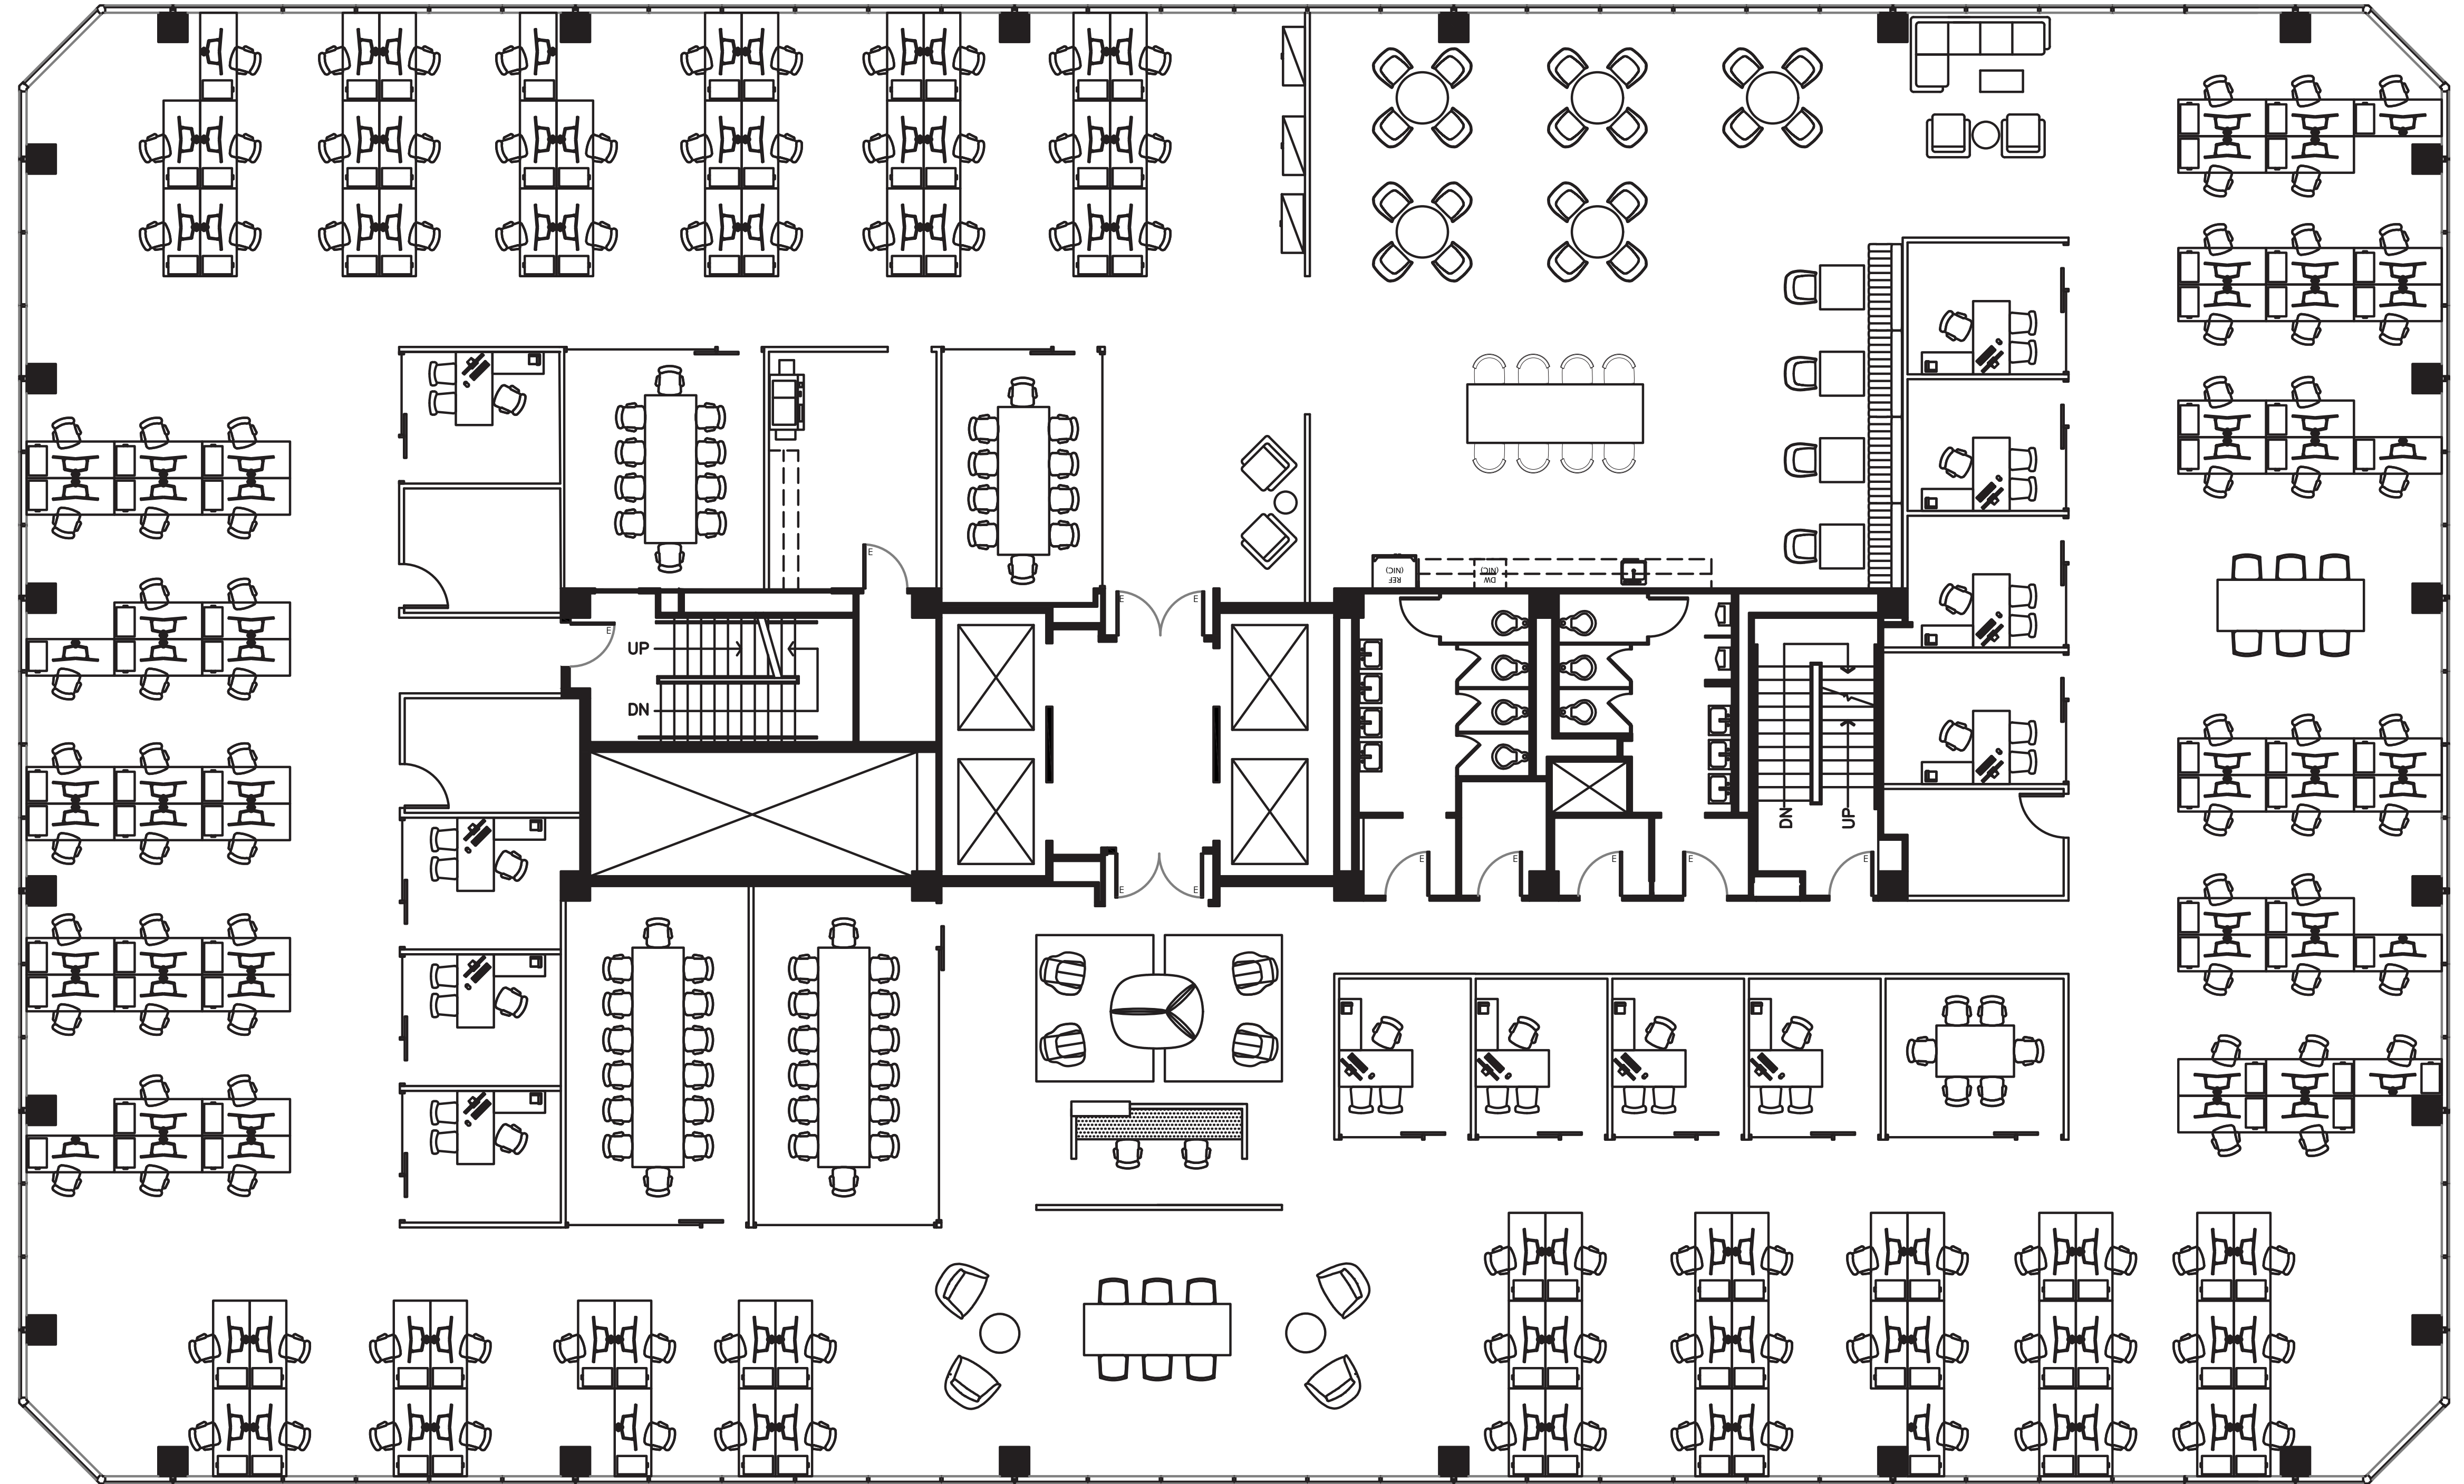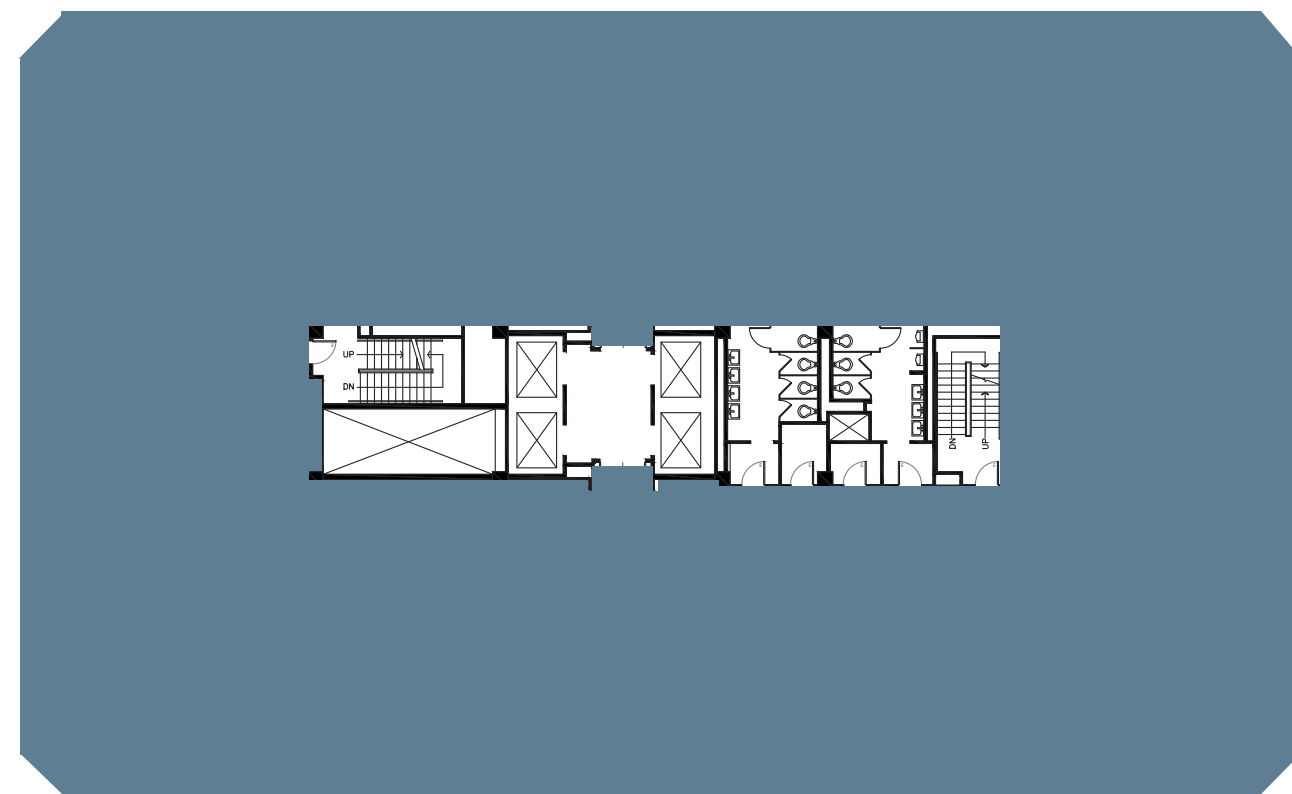

For leasing information please contact:  
USALEASING@ONNI.COM  
(213) 629-2041

