

SUITE: 300

RSF: 5,942



700 BRAND

AS-BUILT CONFIGURATION

PRIVATE OFFICES.....	11
CONFERENCE ROOMS.....	3
KITCHEN.....	1
OPEN WORK AREA.....	+/- 12

Not to scale, furniture and appliances not included

KEY PLAN

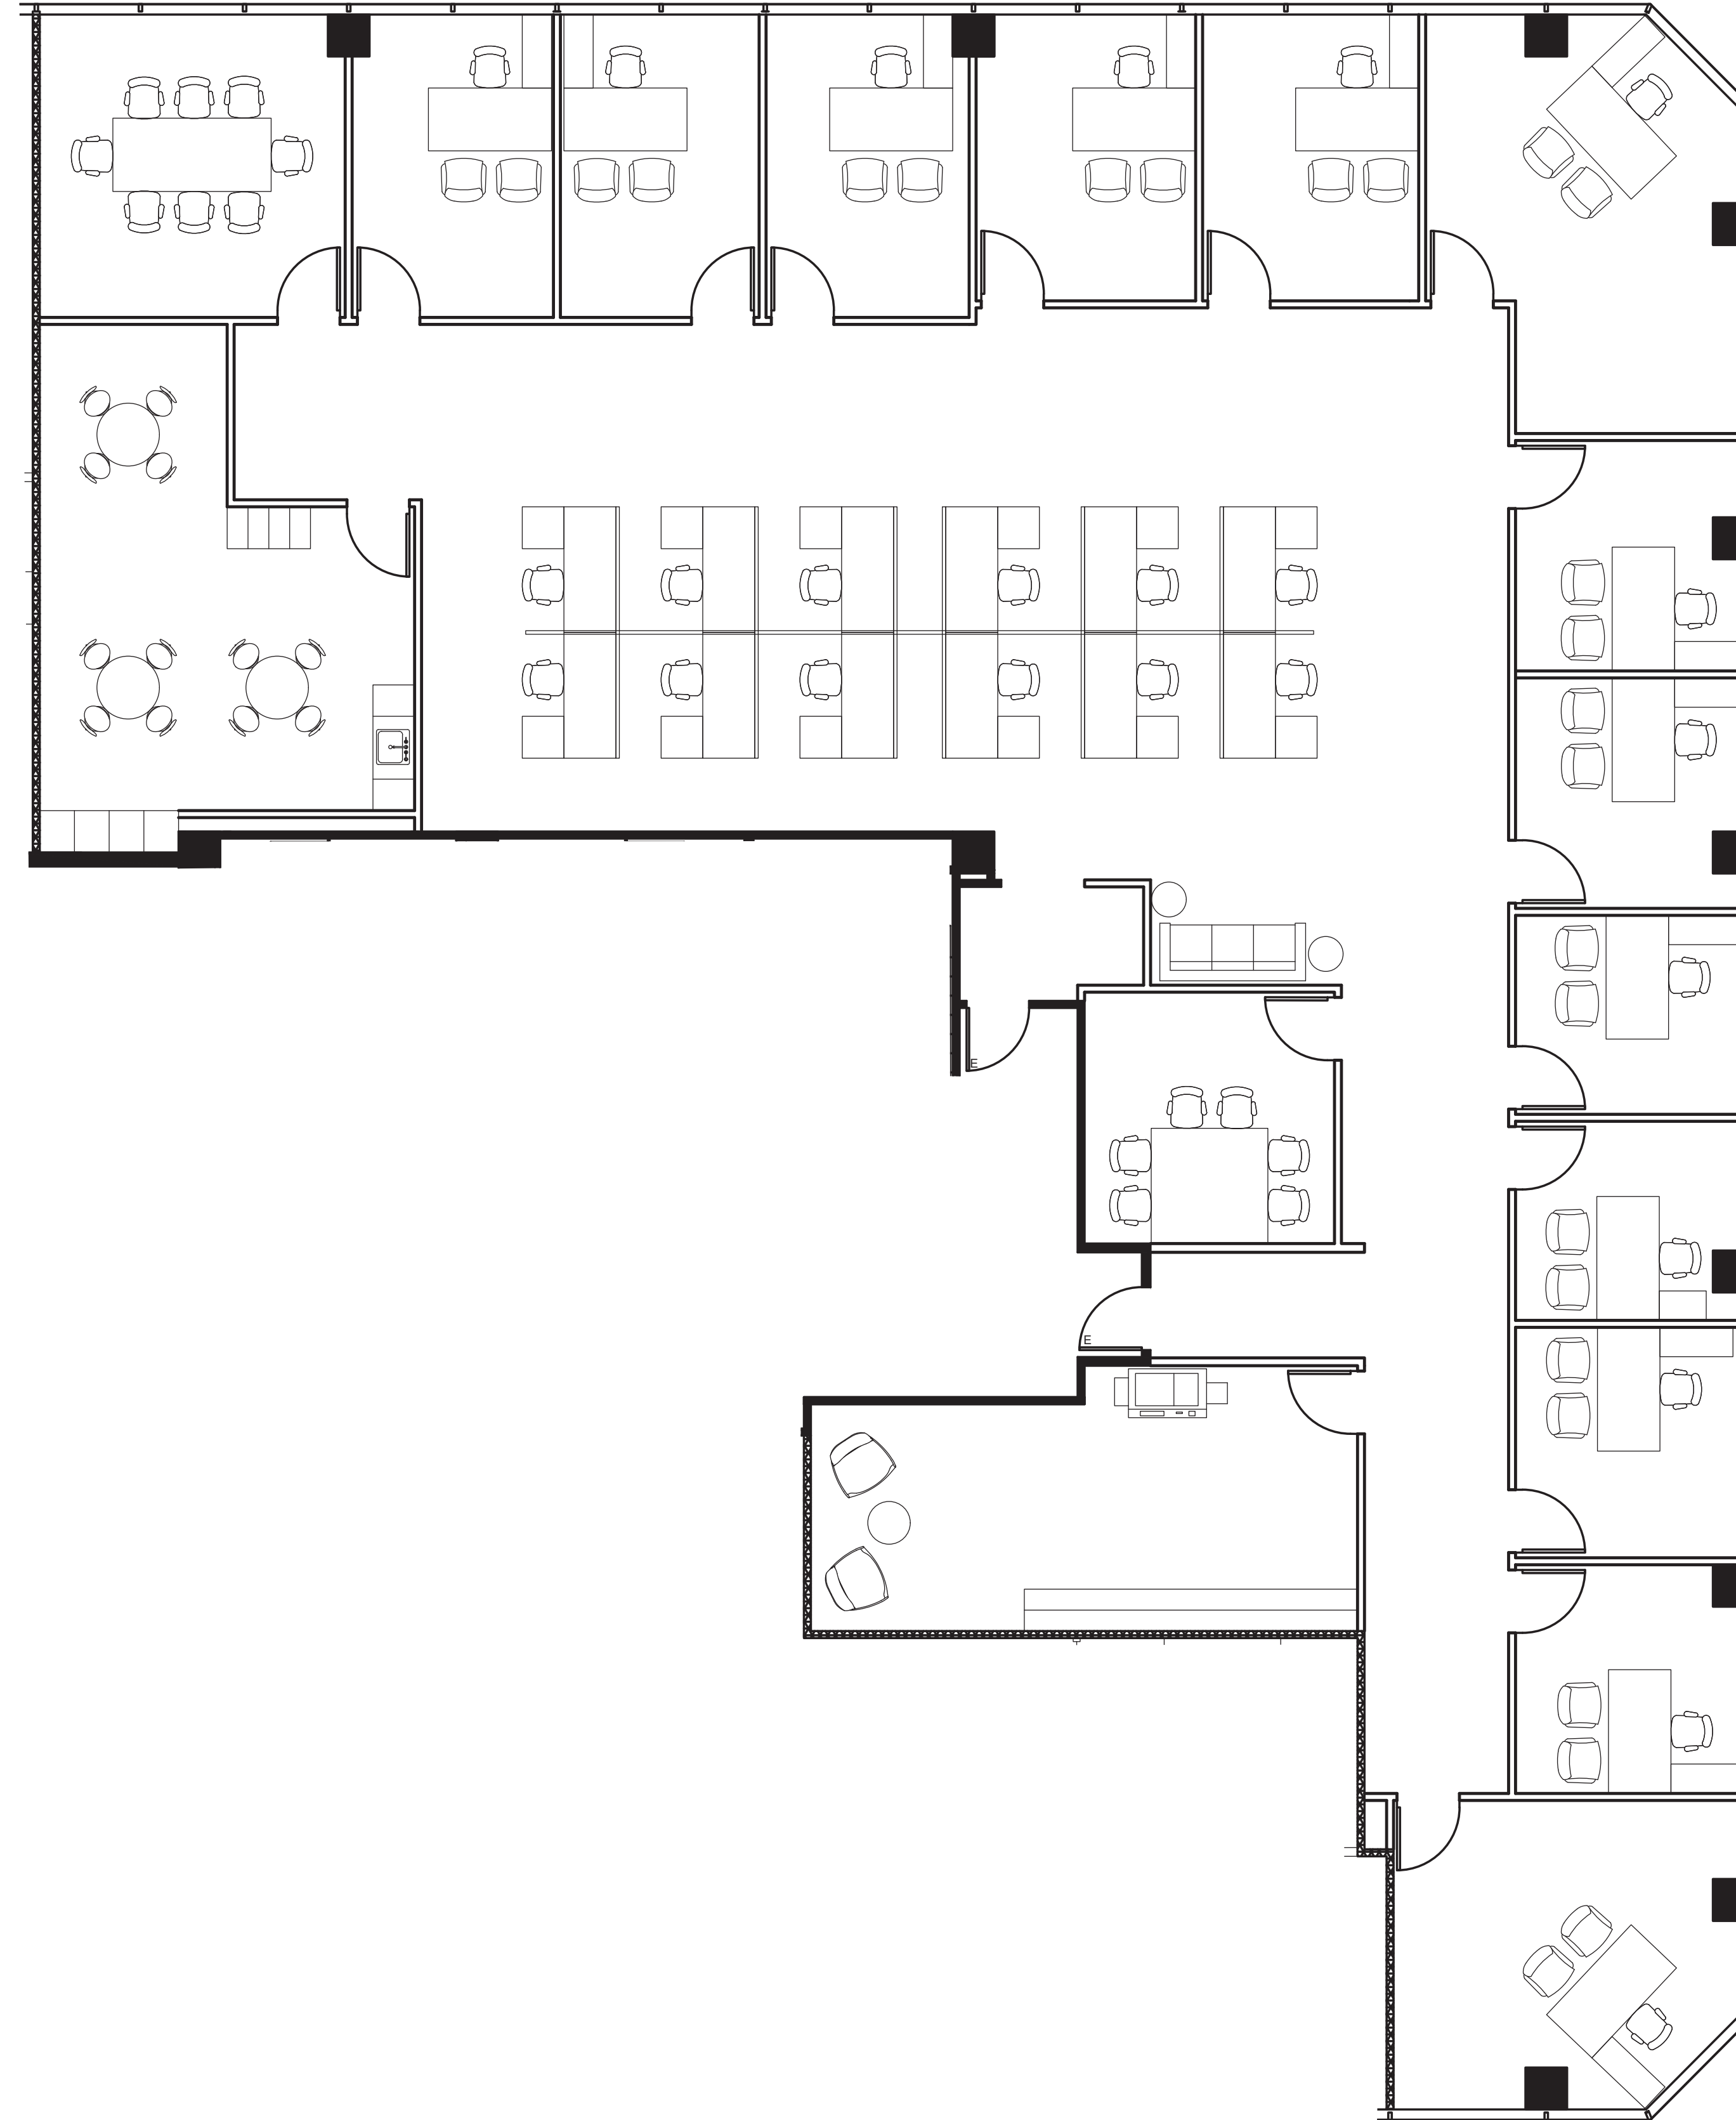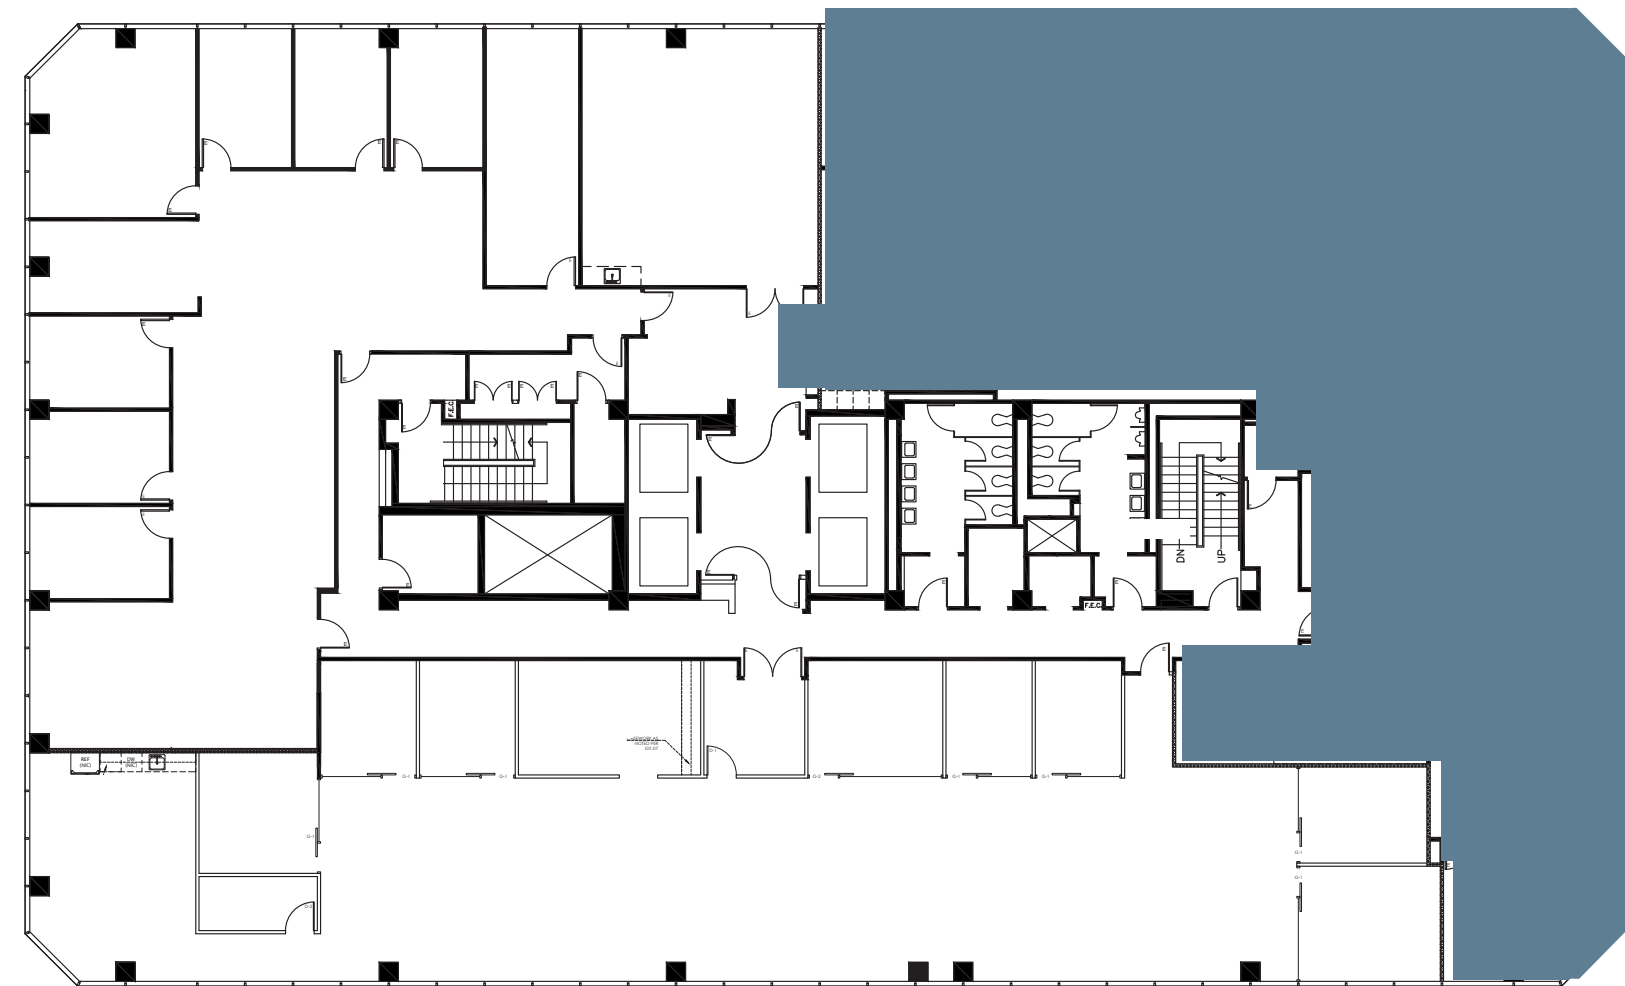

For leasing information please contact:
USALEASING@ONNI.COM
(213) 629-2041