

SUITE: 500

RSF: 3,463



700BRAND

AS-BUILT CONFIGURATION

- OFFICES..... 5
- KITCHEN..... 1
- OPEN WORK AREA..... +/-16

Not to scale, furniture and appliances not included

KEY PLAN

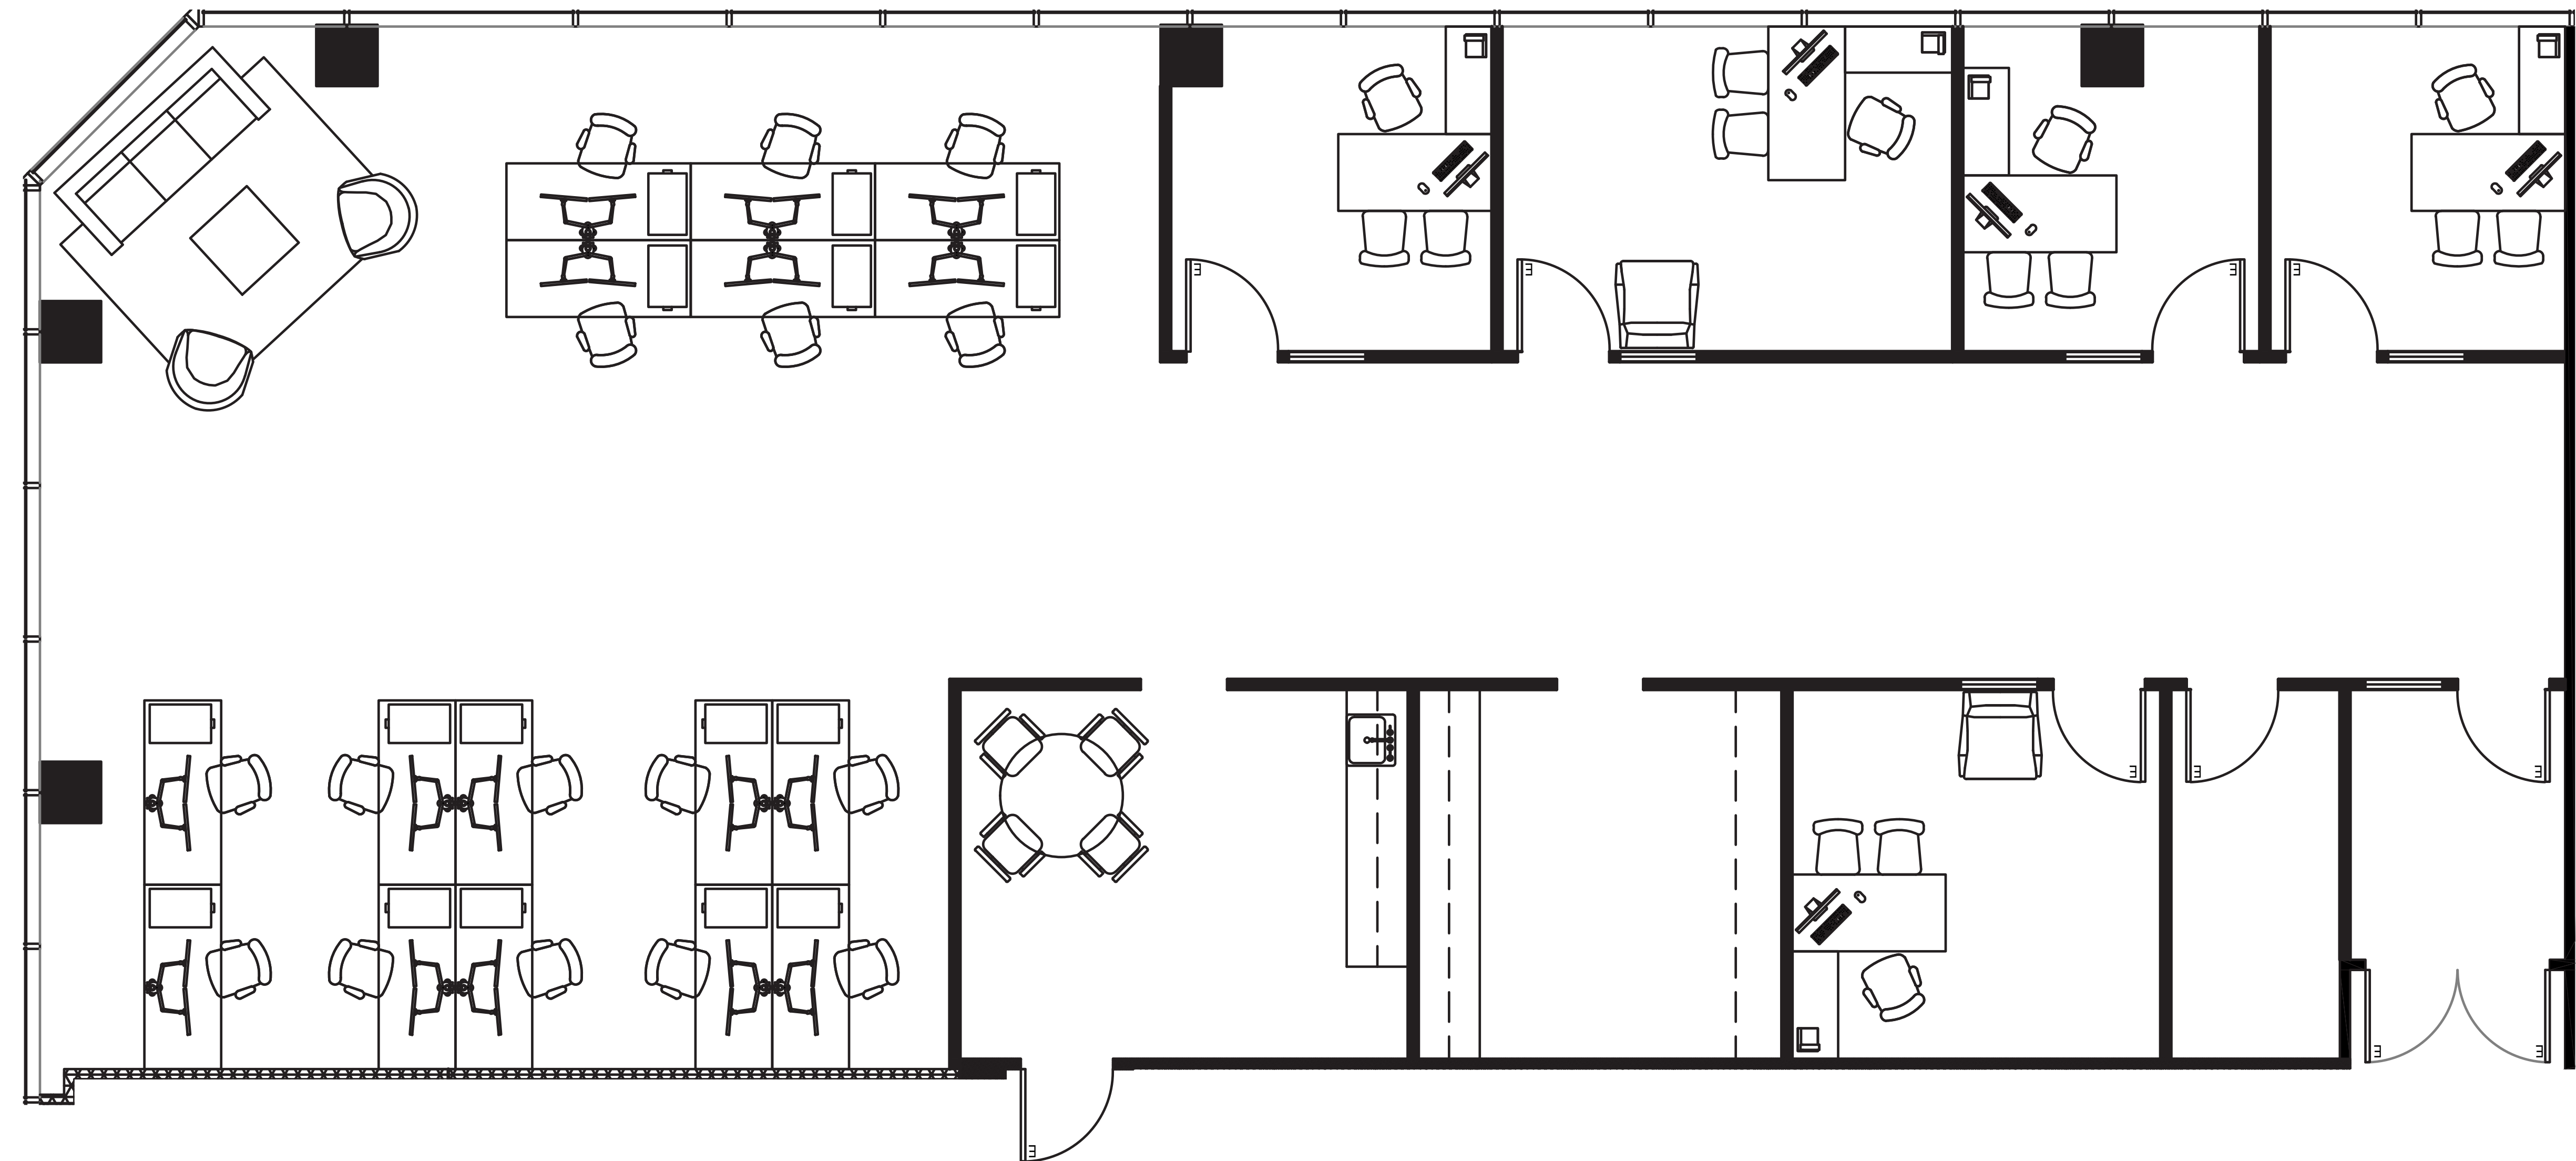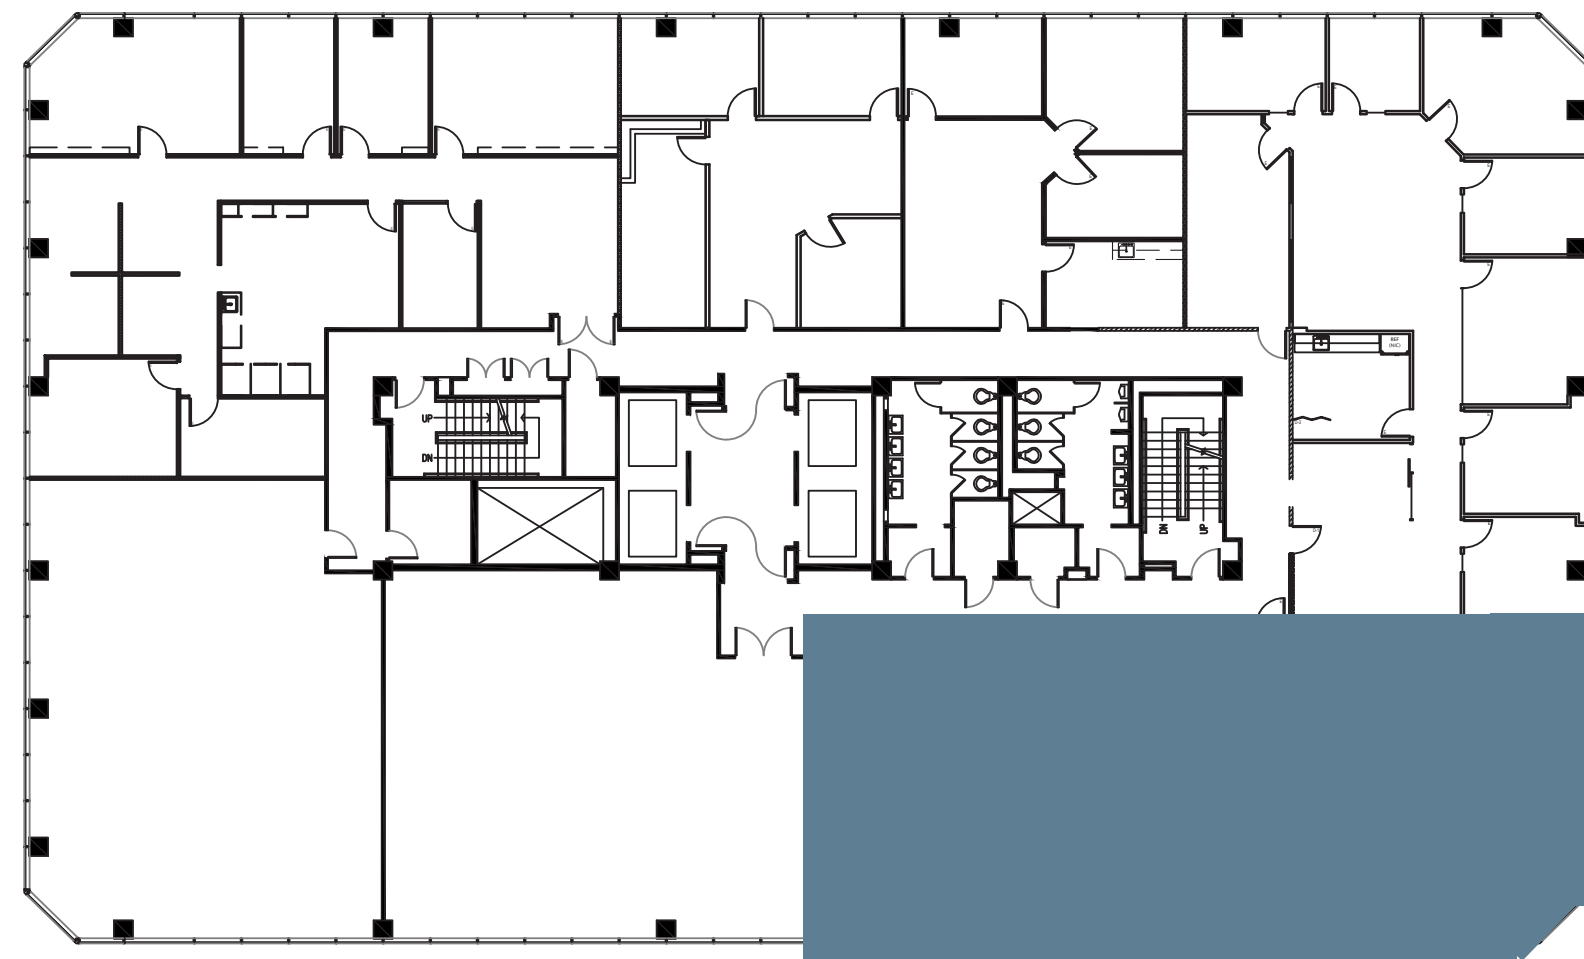

For leasing information please contact:
USALEASING@ONNI.COM
(213) 629-2041

