

SUITE: 840

RSF: 2,302



700 BRAND

AS-BUILT CONFIGURATION

| | |
|-----------------------|--------|
| OFFICES..... | 2 |
| RECEPTION..... | 1 |
| CONFERENCE ROOMS..... | 1 |
| KITCHEN..... | 1 |
| OPEN WORK AREA..... | +/- 15 |

Not to scale, furniture and appliances not included

KEY PLAN

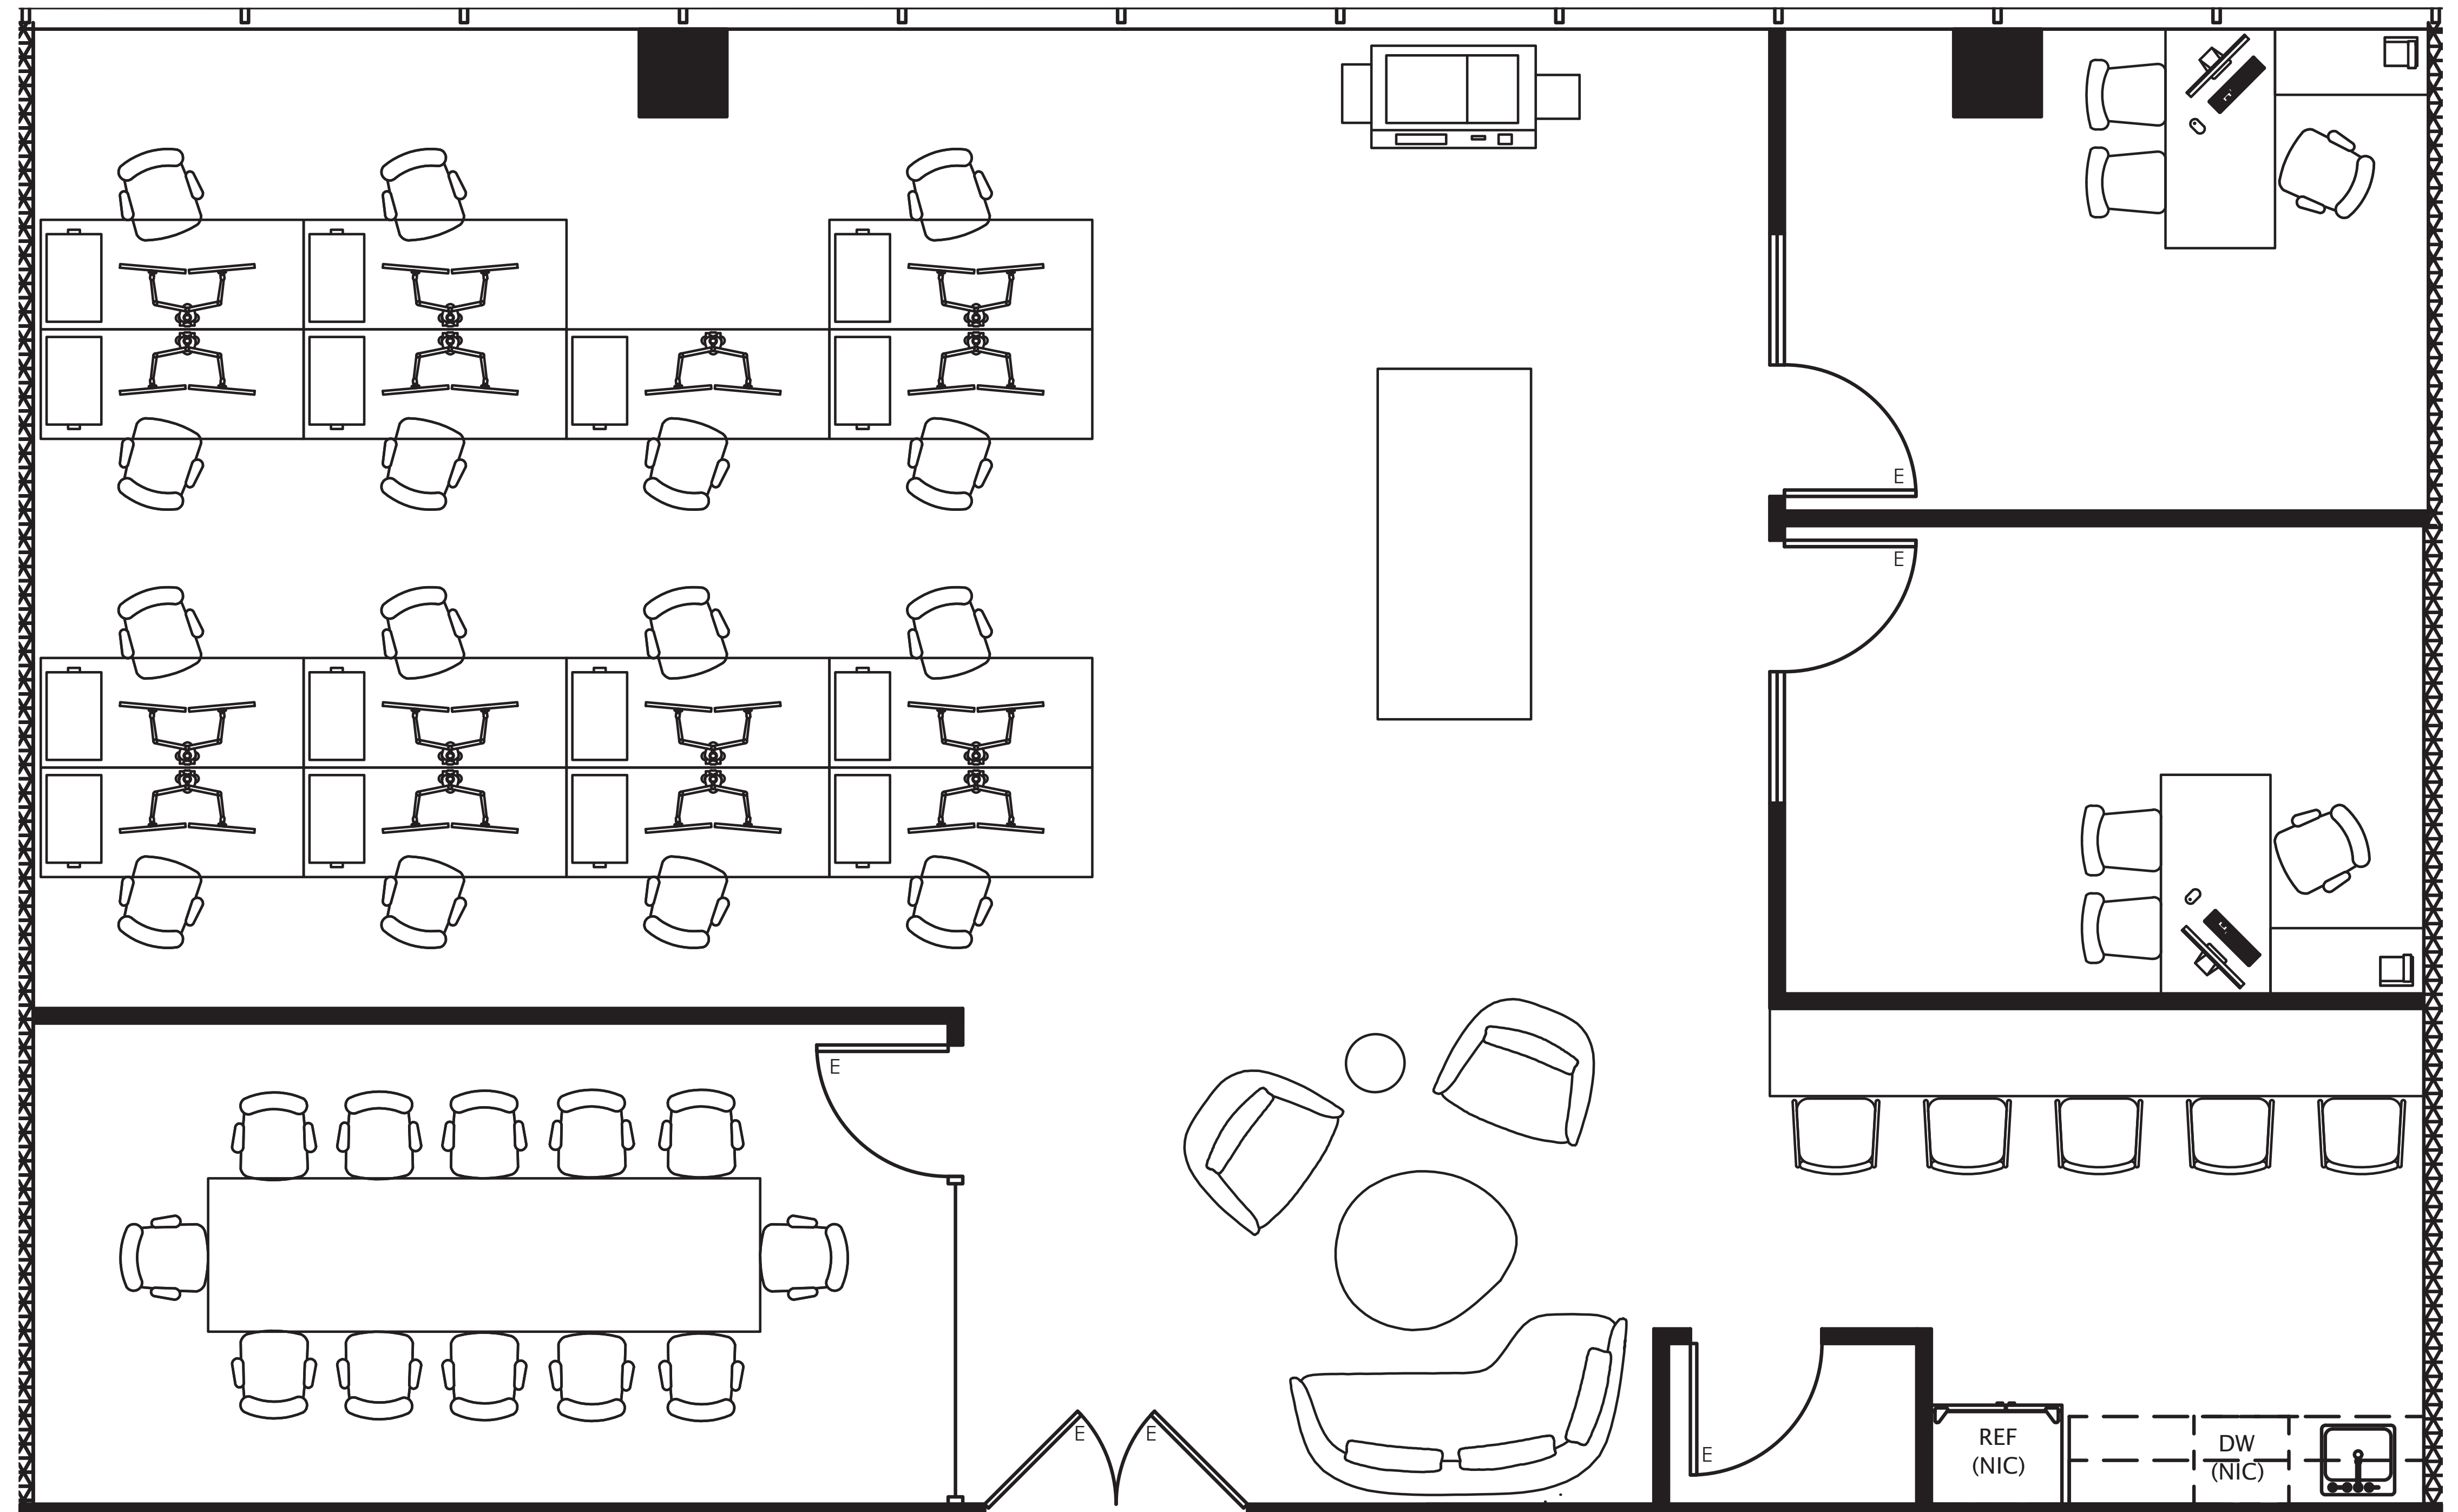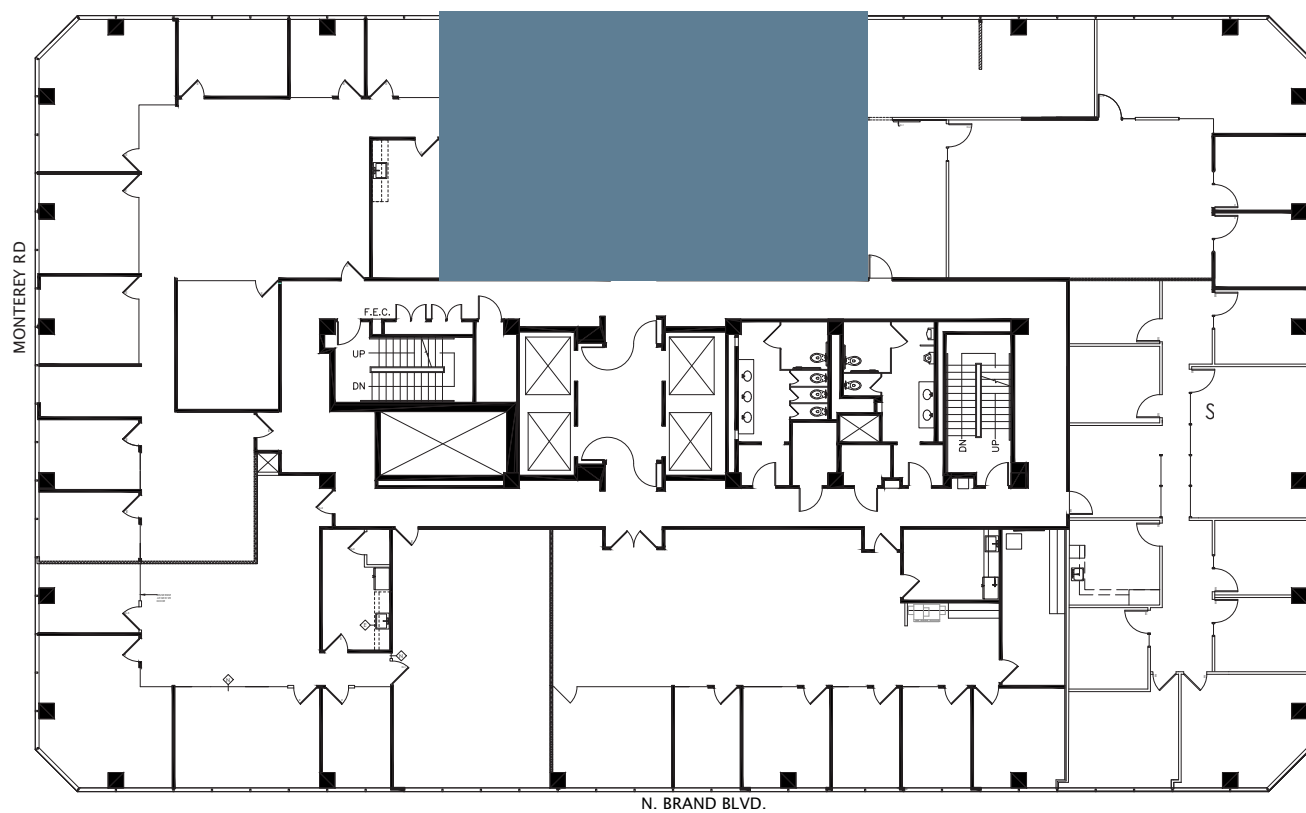

For leasing information please contact:
USALEASING@ONNI.COM
(213) 629-2041