

# SUITE: 920

# RSF: 2,682



# 700BRAND

## AS-BUILT CONFIGURATION

OFFICES.....	2
RECEPTION.....	1
CONFERENCE ROOMS.....	1
KITCHEN.....	1
OPEN WORK AREA.....	+/- 29

*Not to scale, furniture and appliances not included*

## KEY PLAN

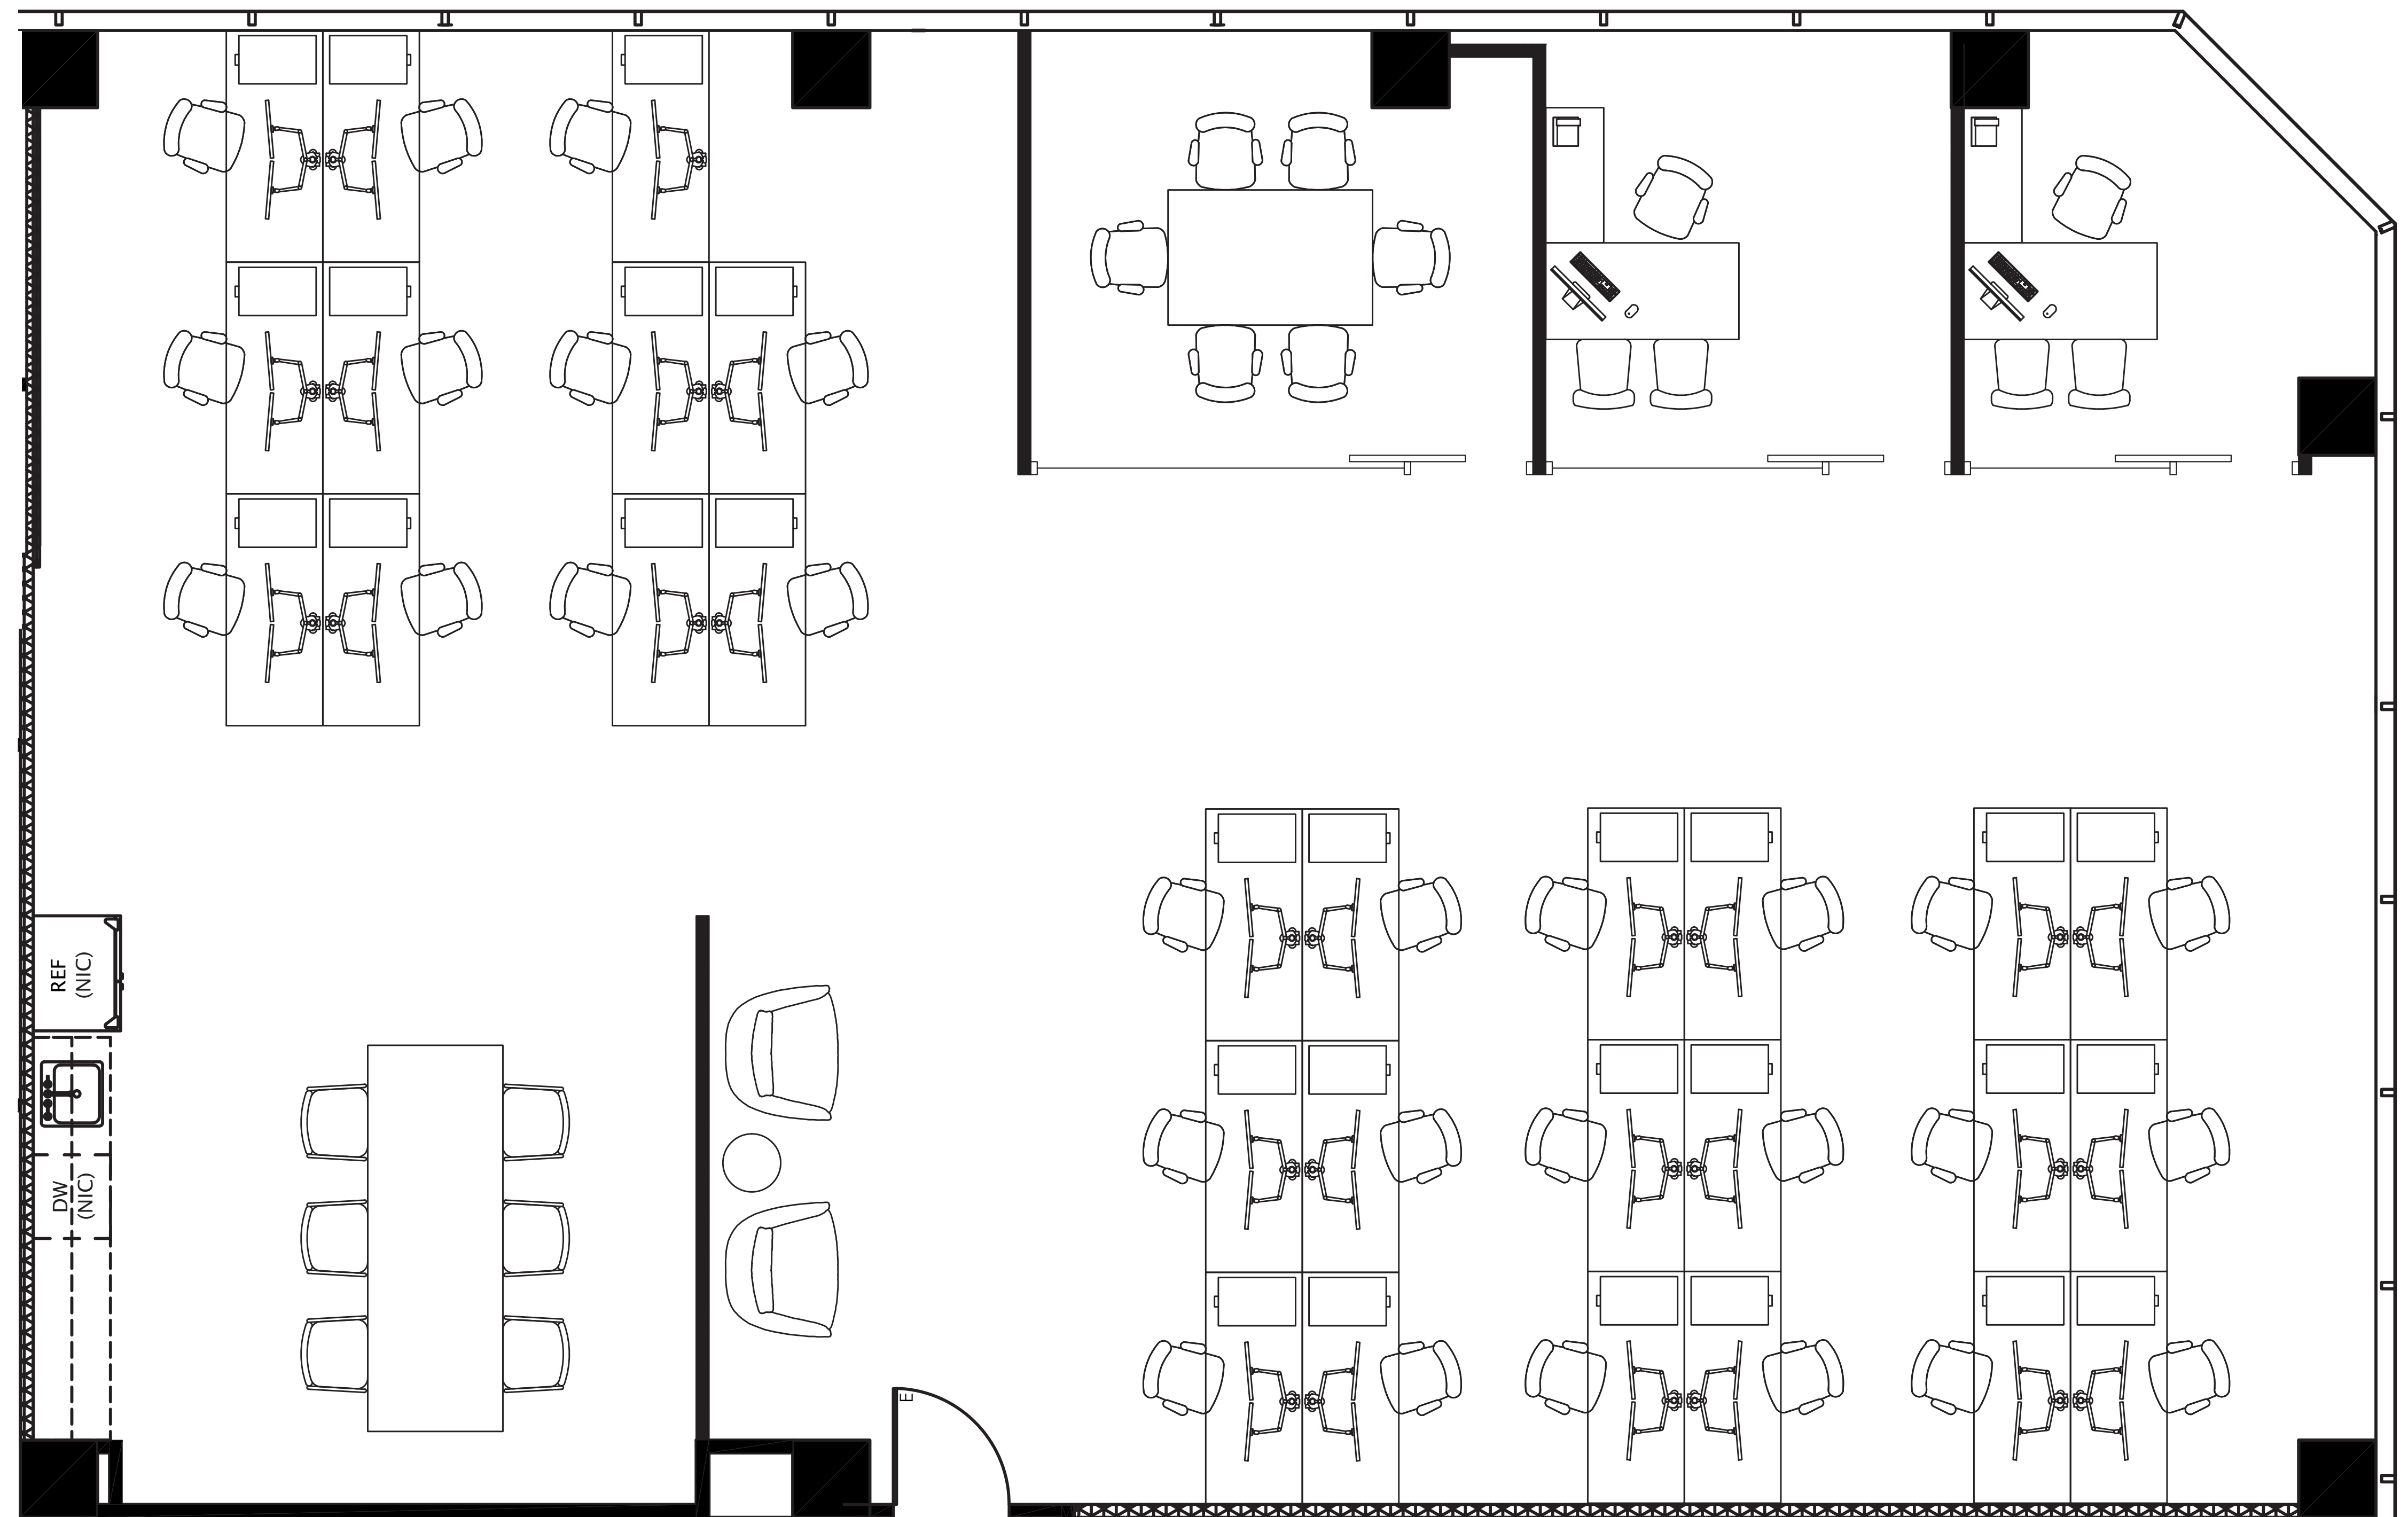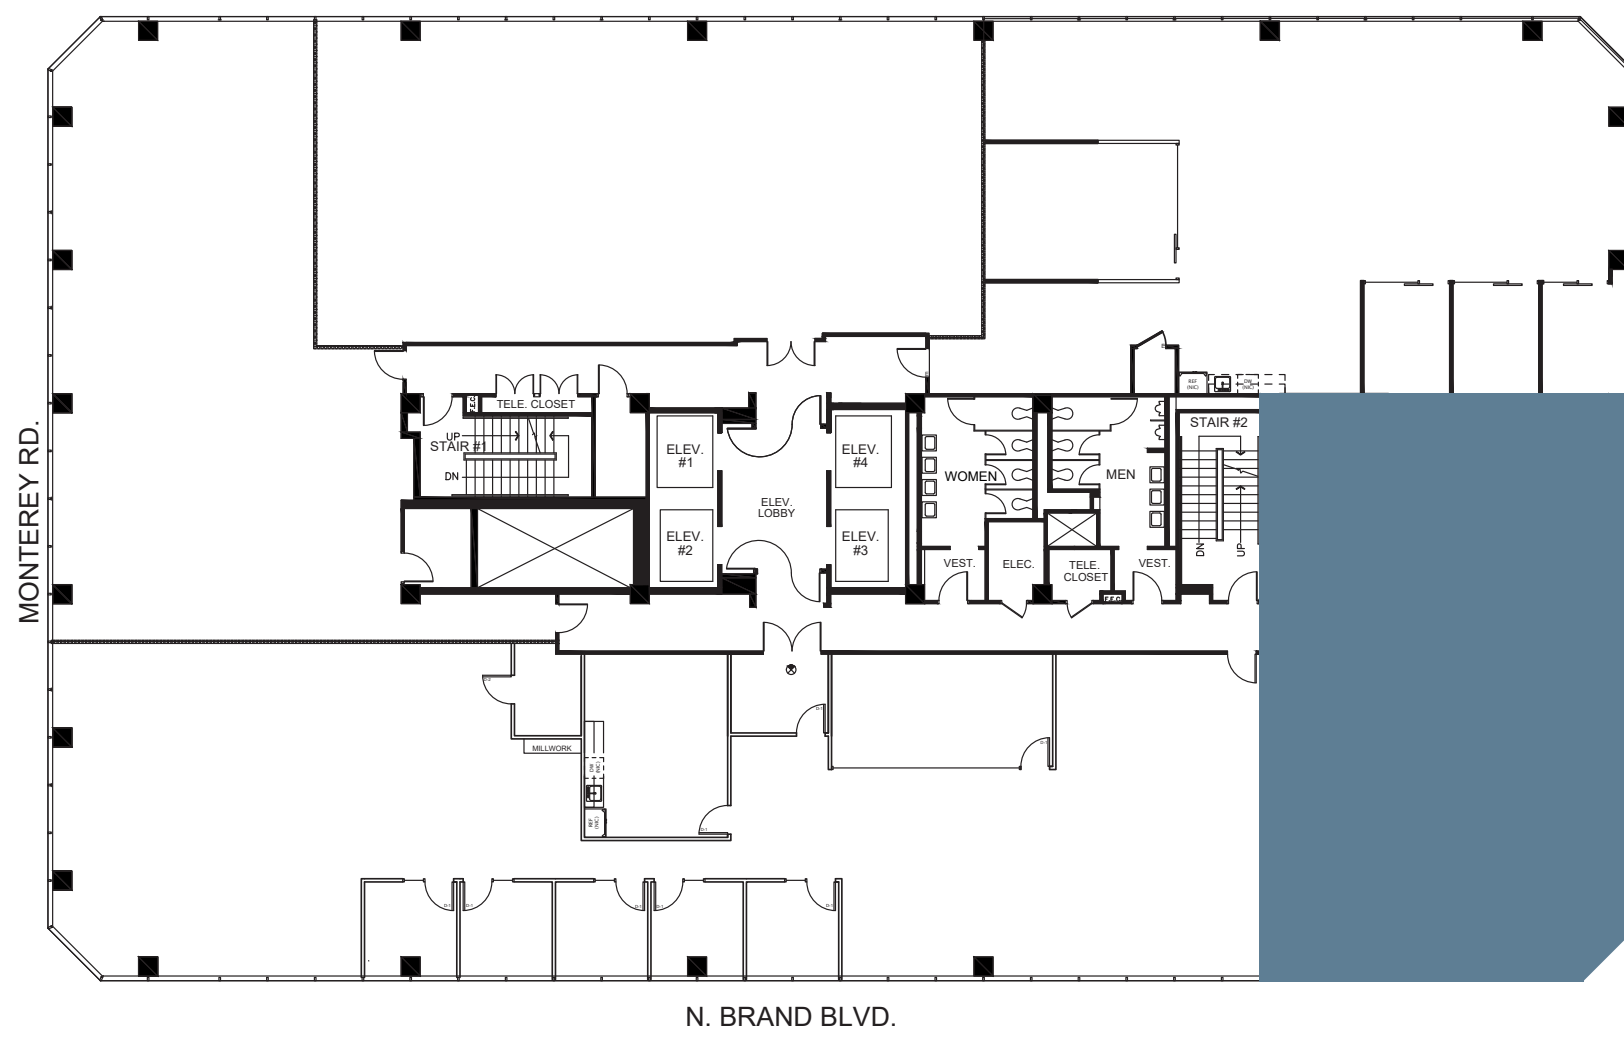

For leasing information please contact:  
USALEASING@ONNI.COM  
(213) 629-2041

