

SUITE: 280

RSF: 437



535 BRAND

AS-BUILT CONFIGURATION

OPEN WORK AREA.....+/-2

KEY PLAN

Not to scale, furniture and appliances not included

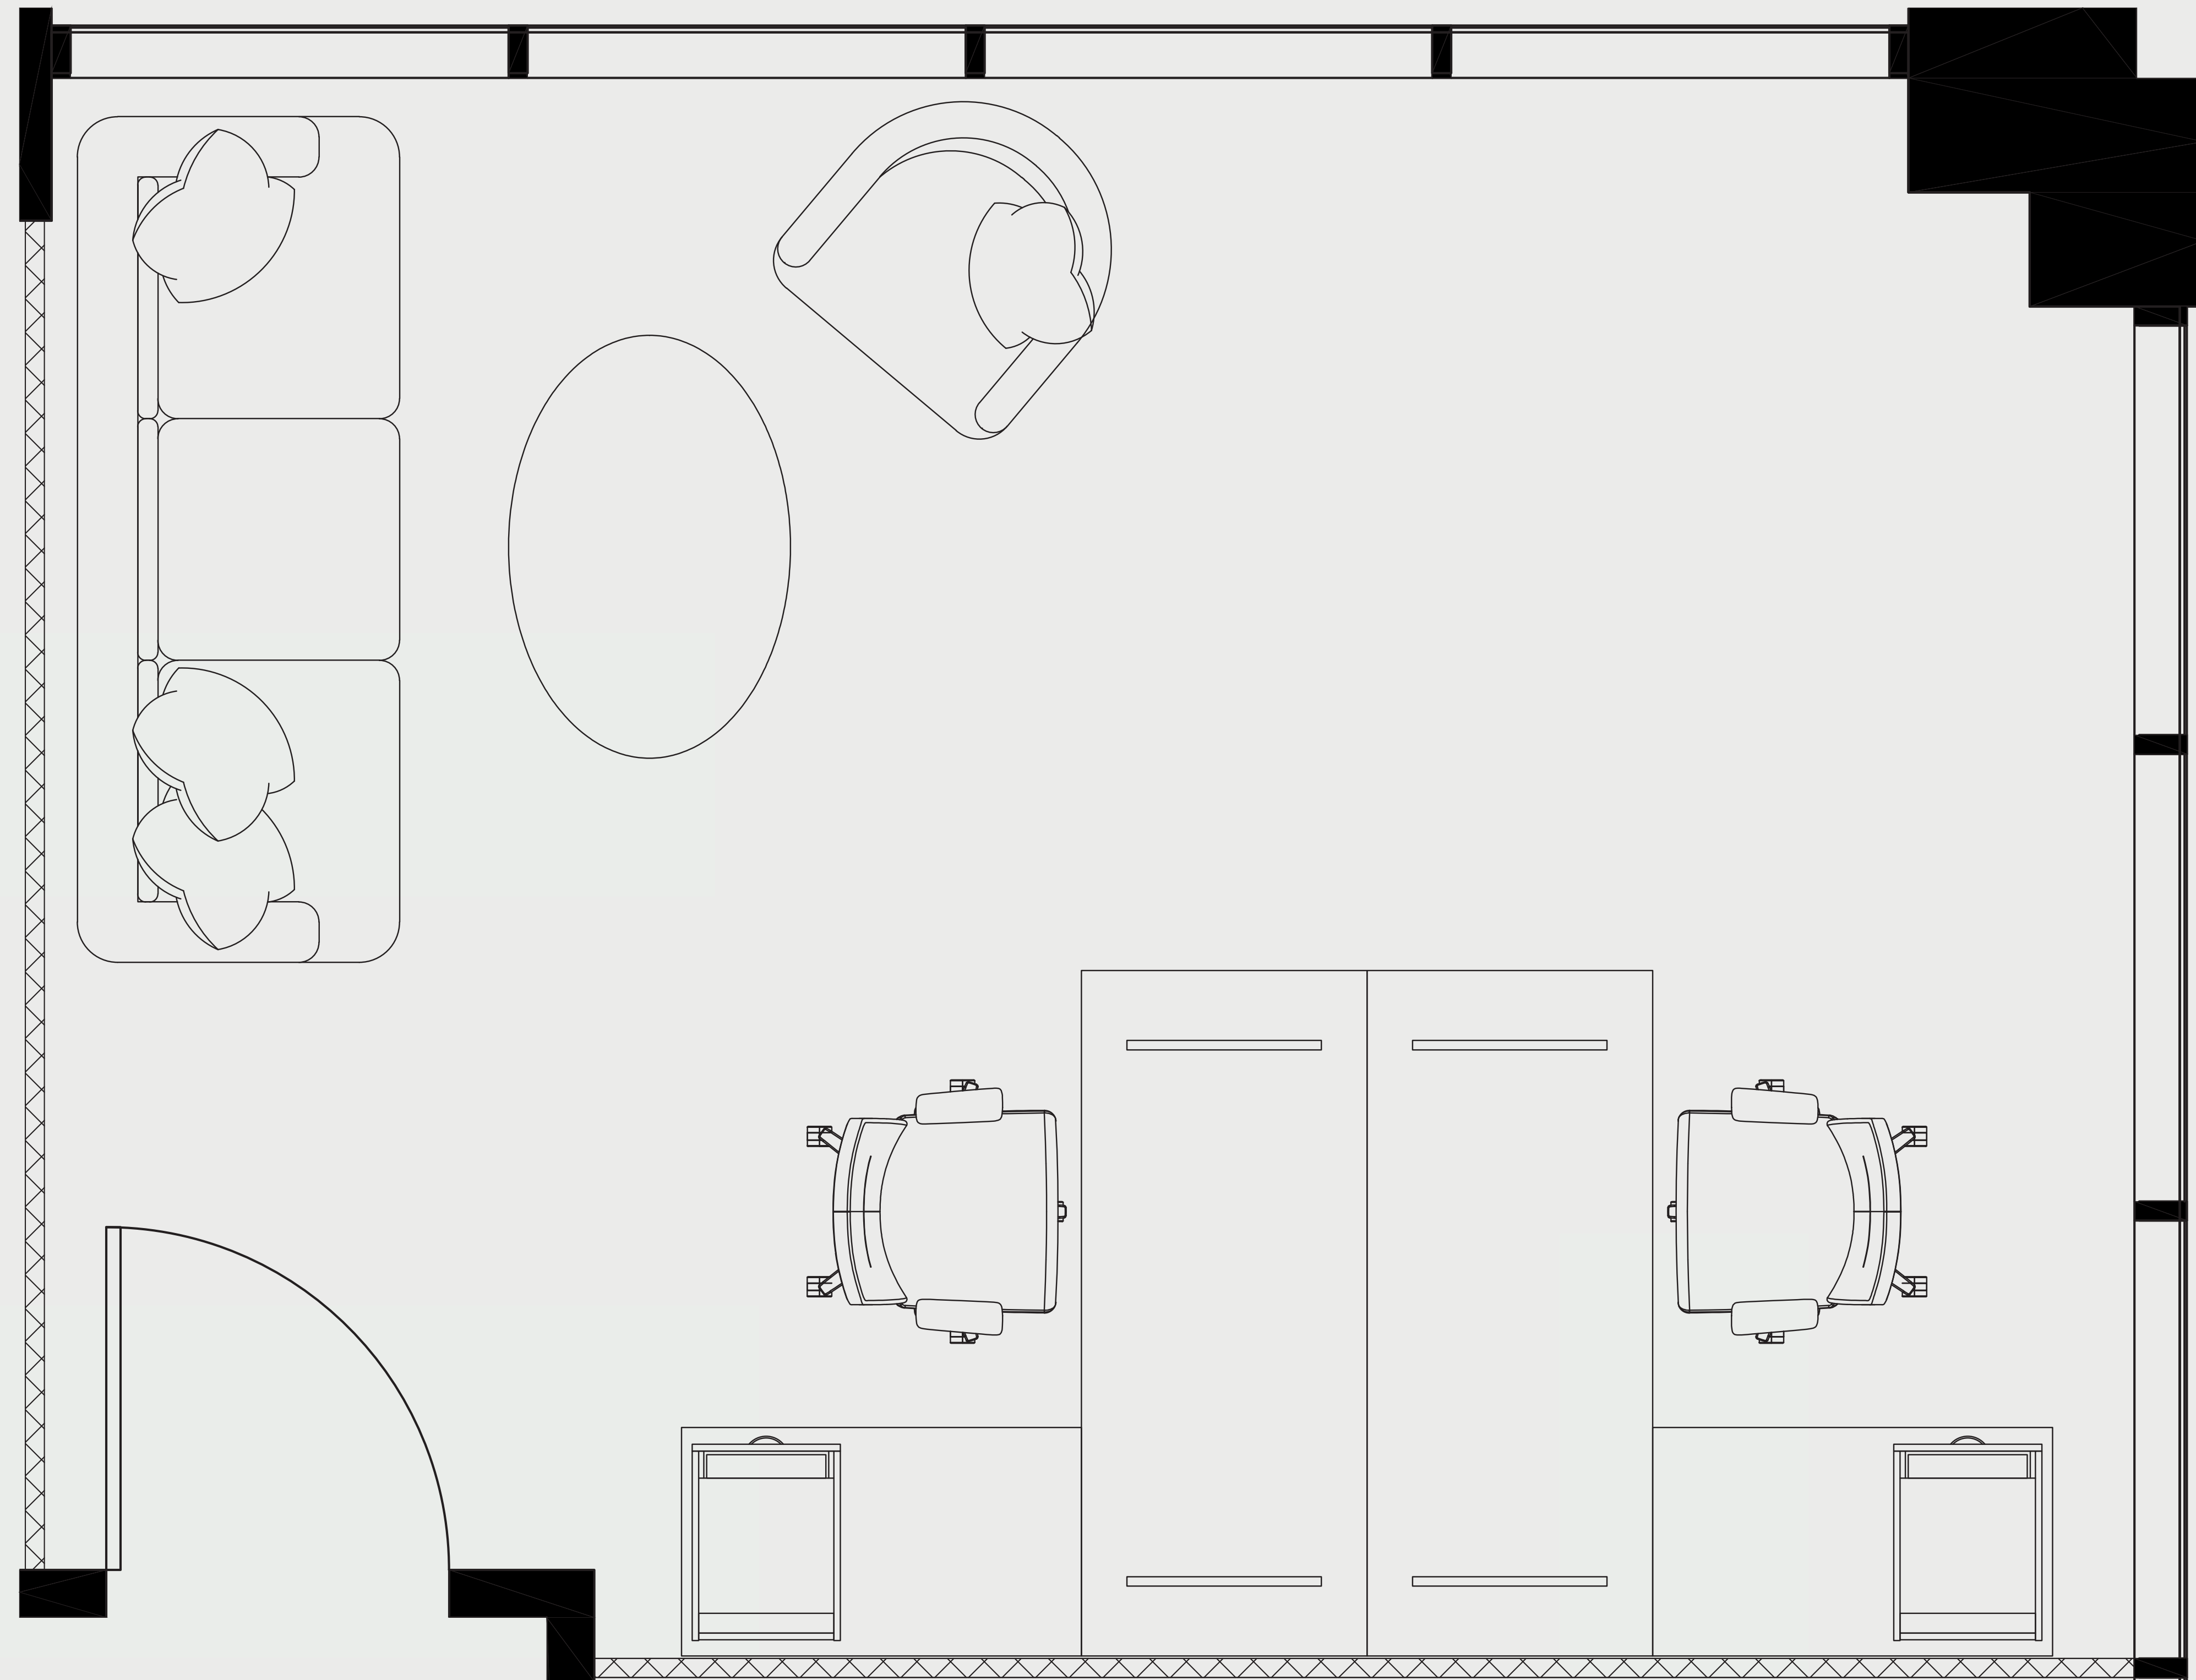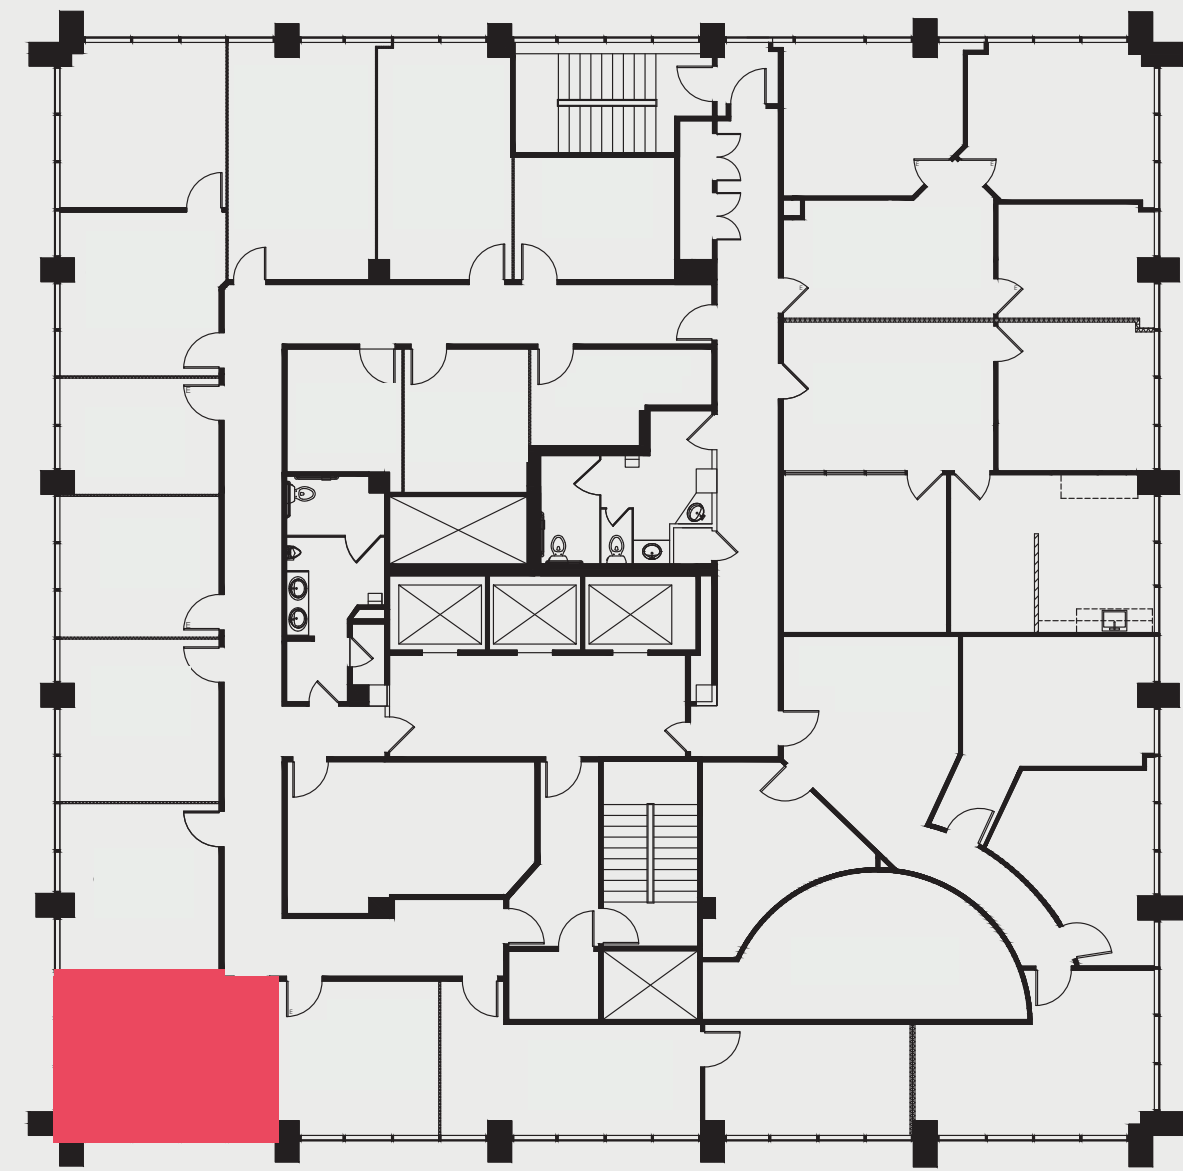

For leasing information please contact:

USALEASING@ONNI.COM
(213) 629-2041

