

SUITE: 570

RSF: 1,232



700 BRAND

AS-BUILT CONFIGURATION

PRIVATE OFFICES.....	2
CONFERENCE ROOMS.....	1
OPEN WORK AREA.....	+/-3

KEY PLAN

Not to scale, furniture and appliances not included

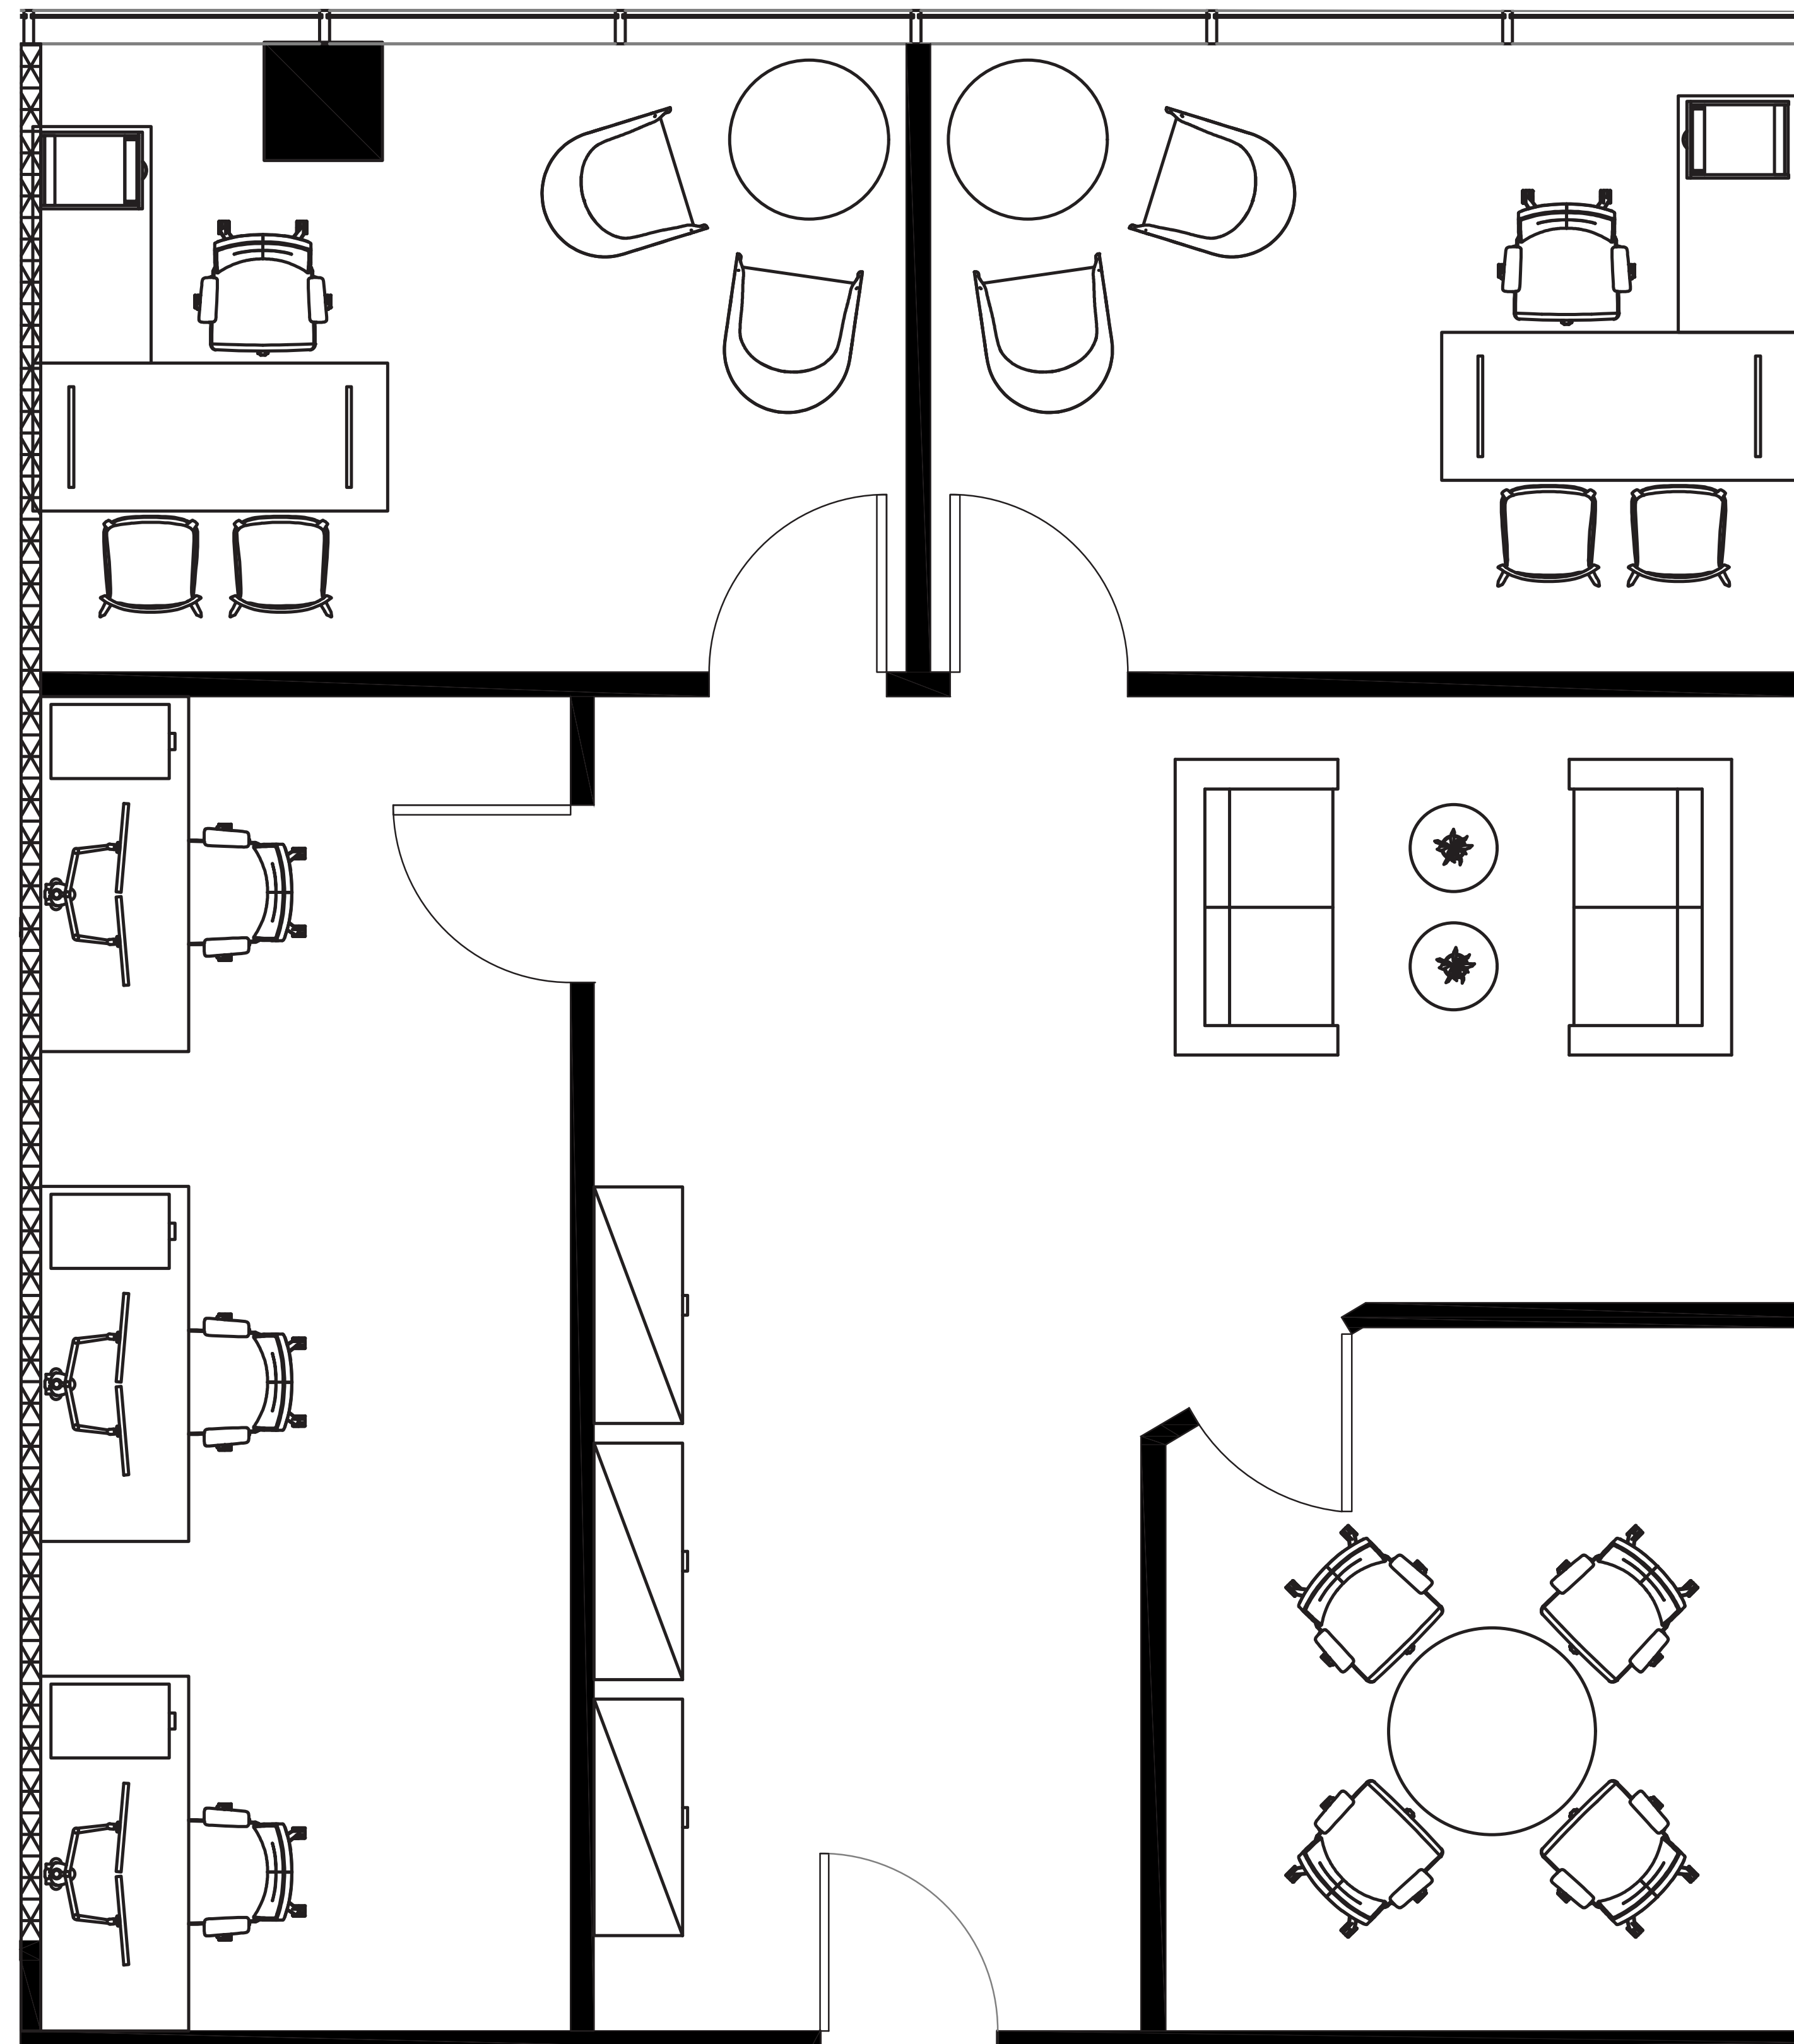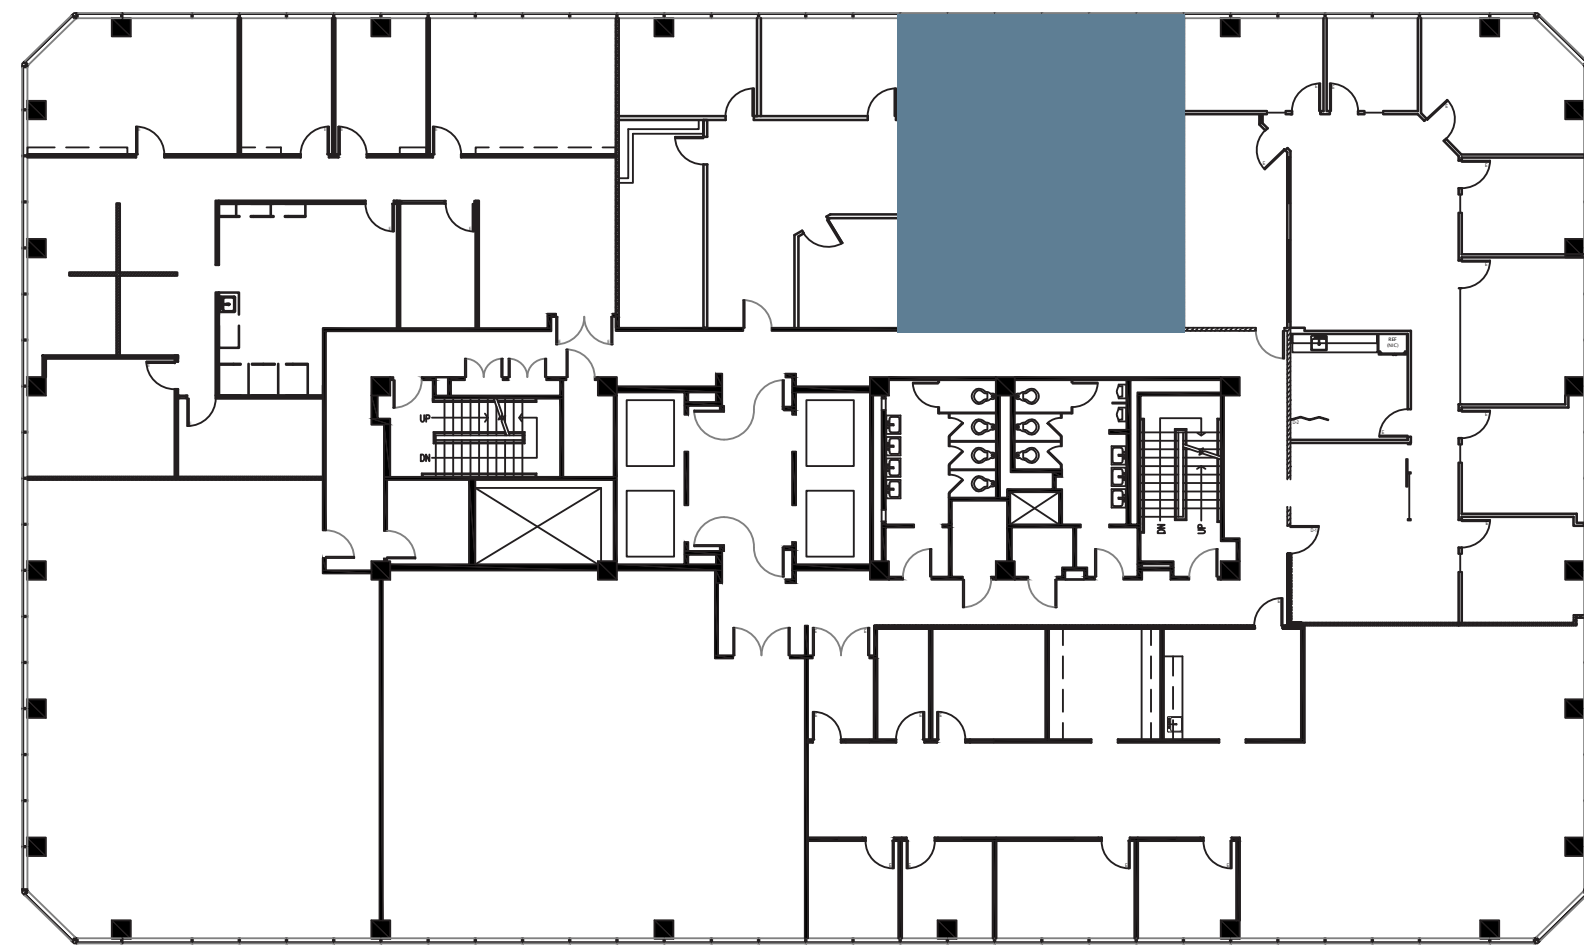

For leasing information please contact:
USALEASING@ONNI.COM
(213) 629-2041