


SUITE: 605

RSF: 2,720

535 BRAND

AS-BUILT CONFIGURATION

OFFICES.....	2
RECEPTION.....	1
CONFERENCE ROOMS.....	1
KITCHEN/BREAKOUT	1
OPEN WORK AREA.....	+/- 16

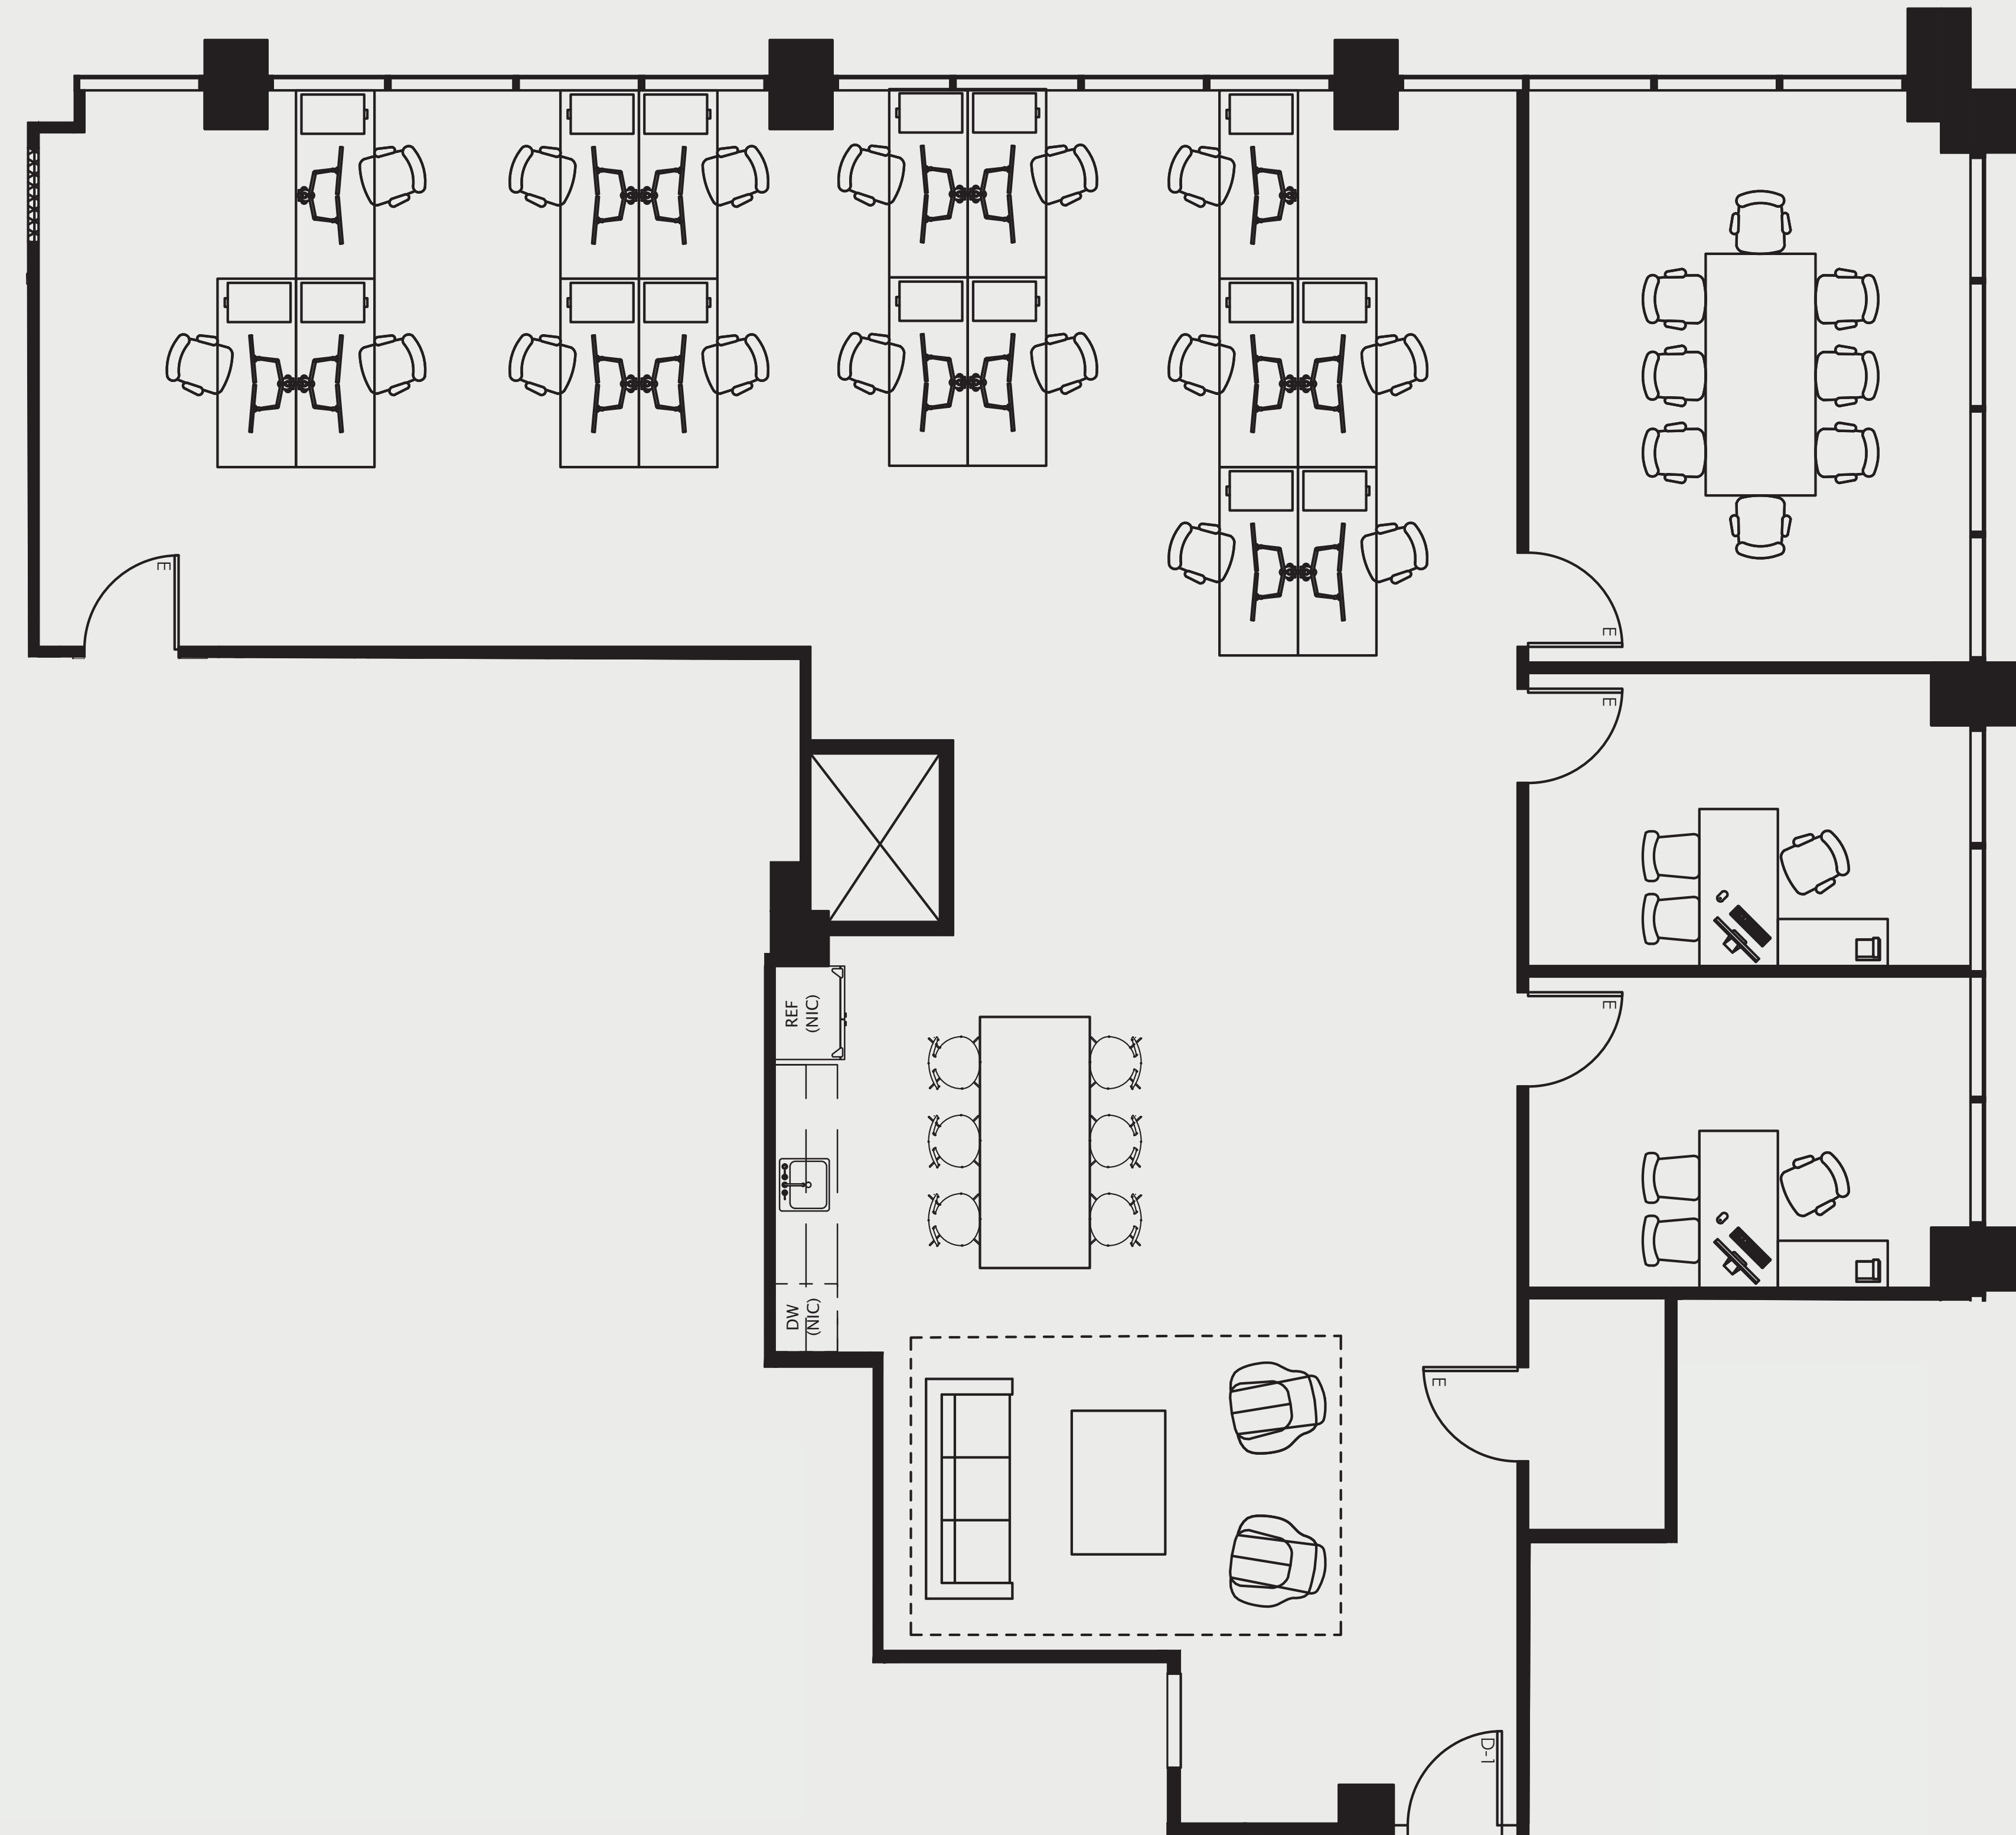

KEY PLAN



For leasing information please contact:

USALEASING@ONNI.COM
(213) 629-2041