

SUITE: 1400

RSF: 16,484



700 BRAND

AS-BUILT CONFIGURATION

PRIVATE OFFICES.....	48
RECEPTION.....	1
CONFERENCE ROOMS.....	3
KITCHEN.....	1
OPEN WORK AREA.....	24

Not to scale, furniture and appliances not included

KEY PLAN

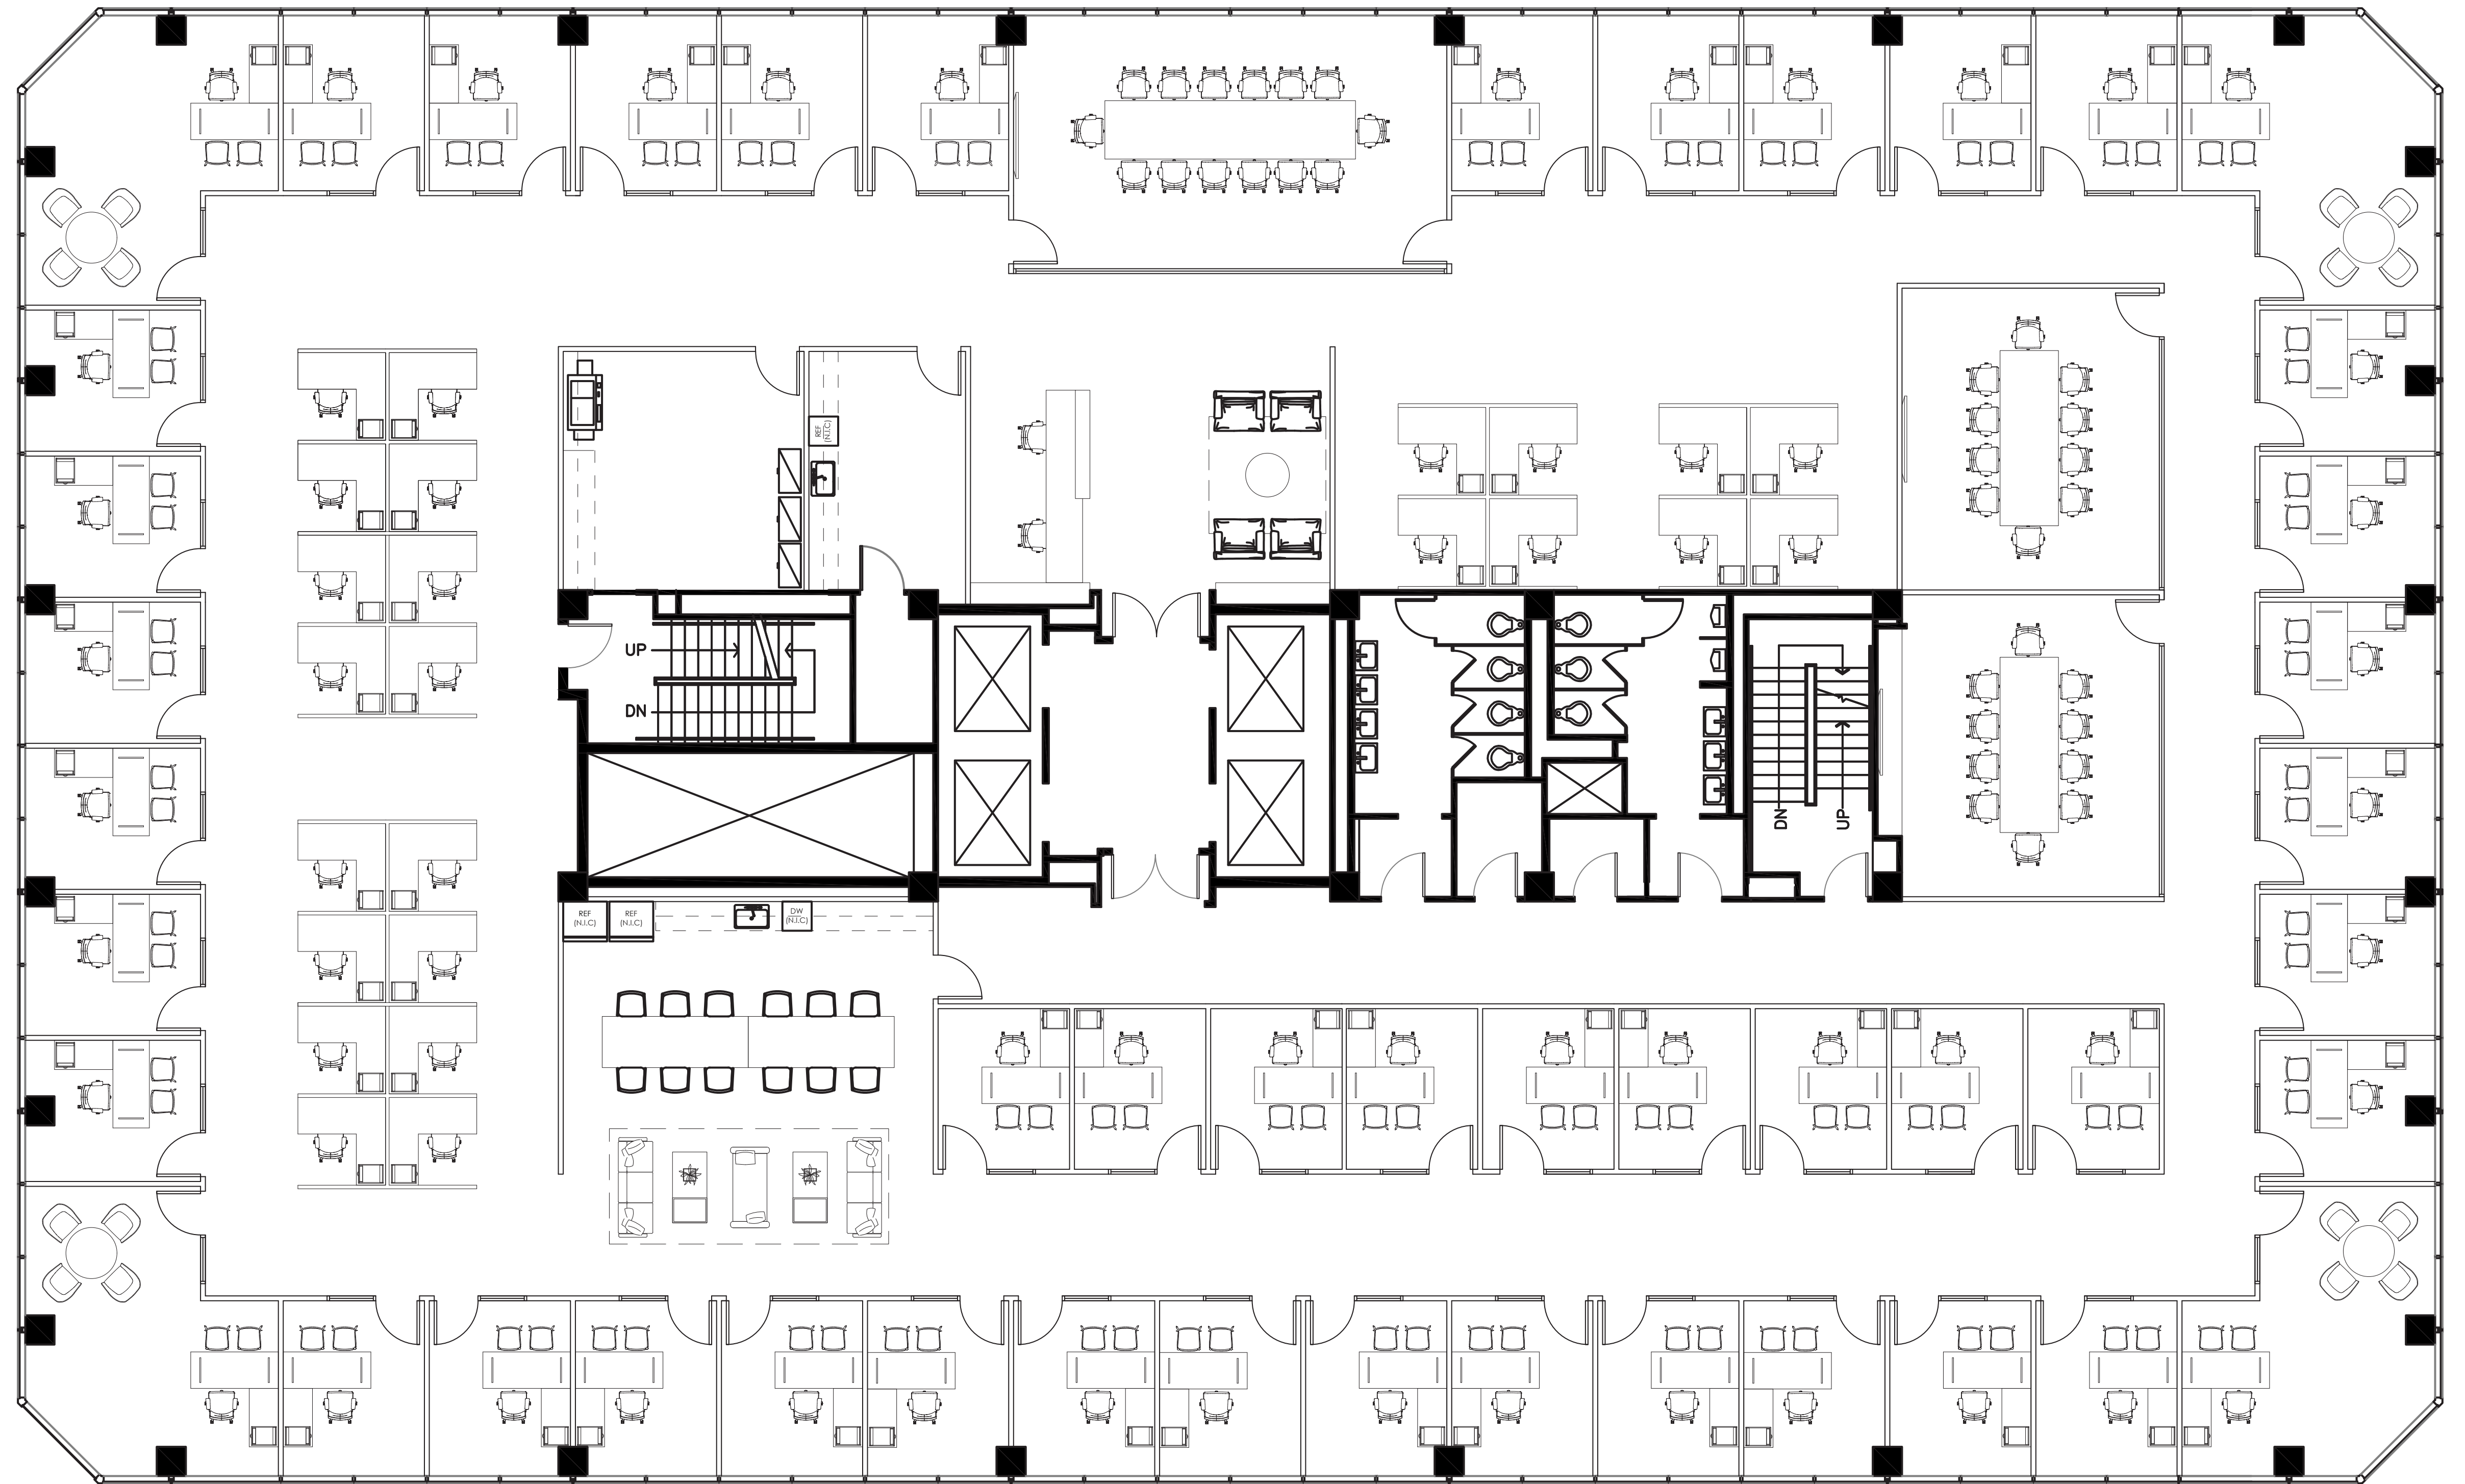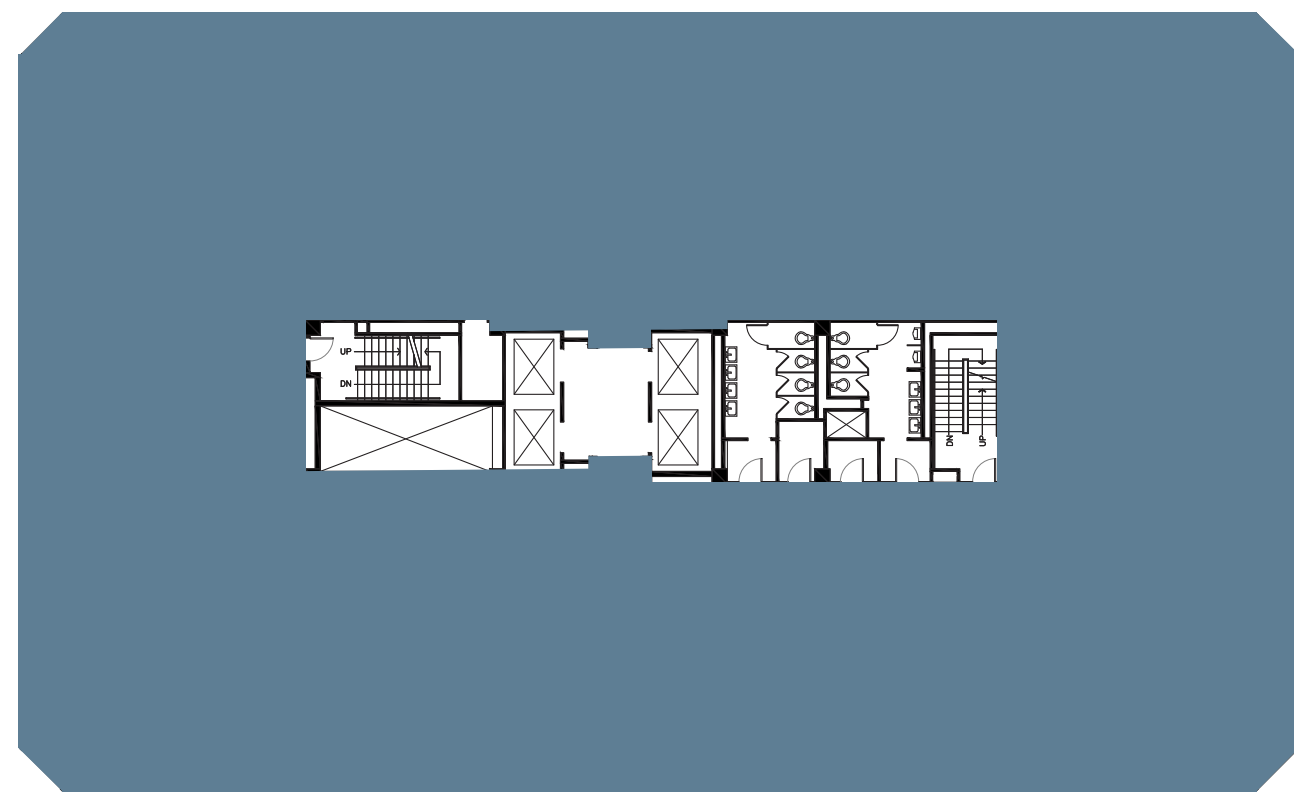

For leasing information please contact:
USALEASING@ONNI.COM
(213) 629-2041