

SUITE: 800

RSF: 2,804



700BRAND

AS-BUILT CONFIGURATION

- OFFICES..... 5
- RECEPTION..... 1
- CONFERENCE ROOMS..... 1
- KITCHEN..... 1
- OPEN WORK AREA..... +/- 12

Not to scale, furniture and appliances not included

KEY PLAN

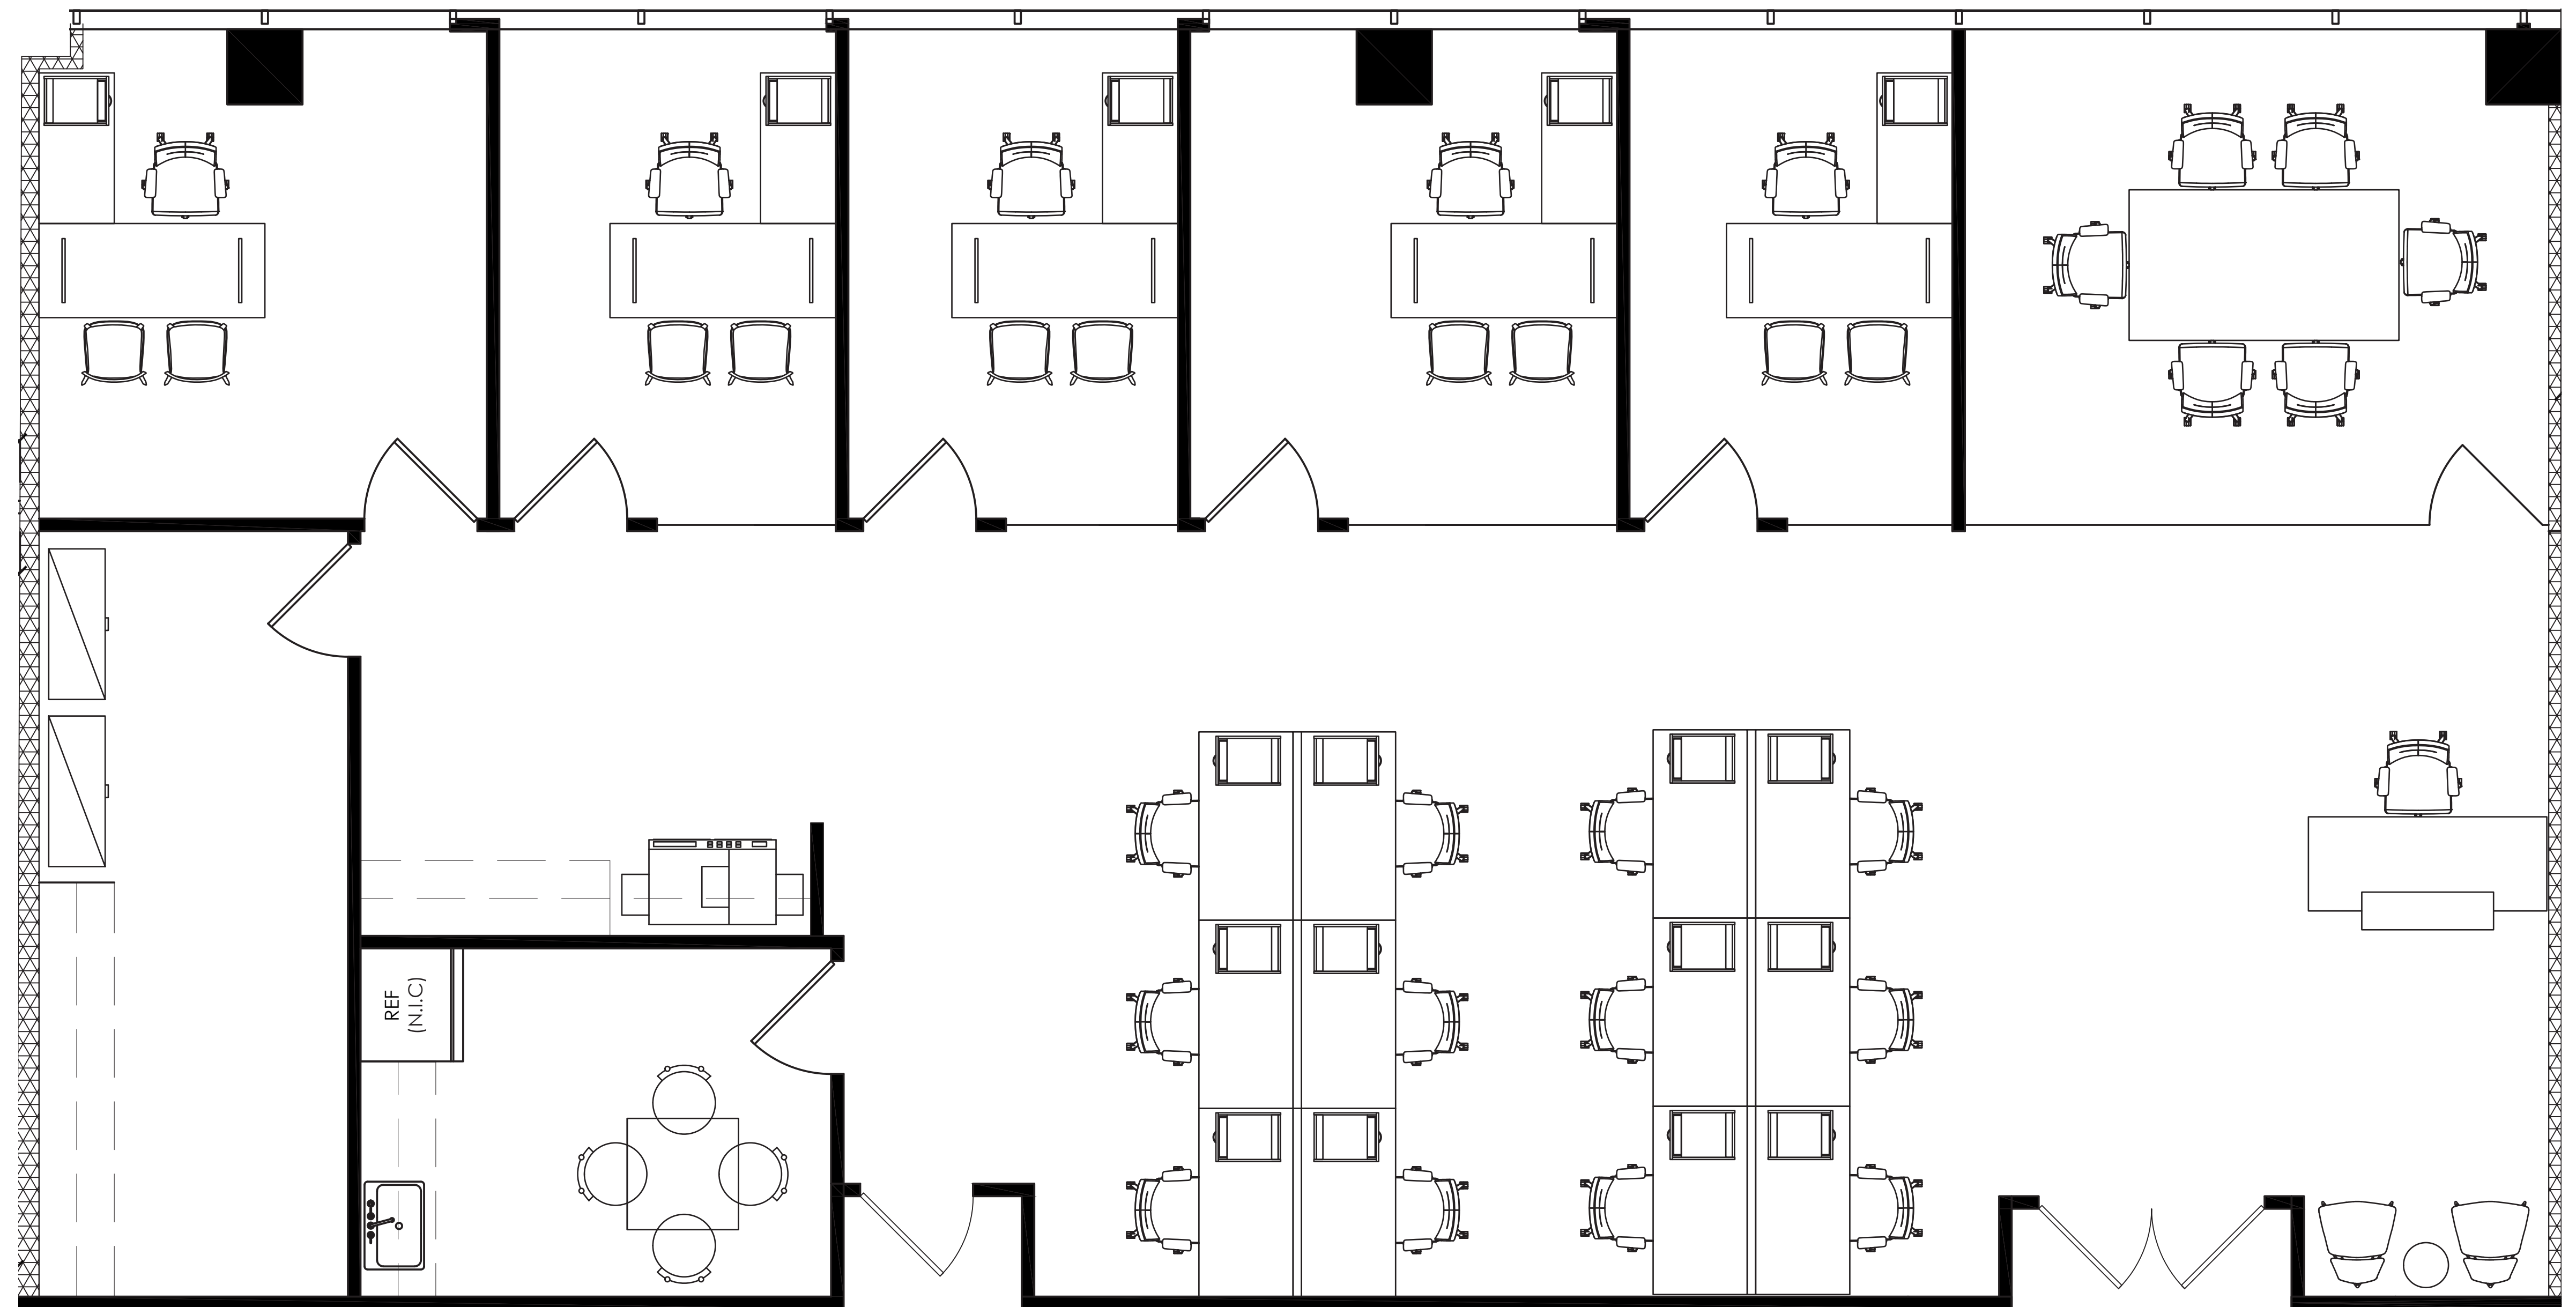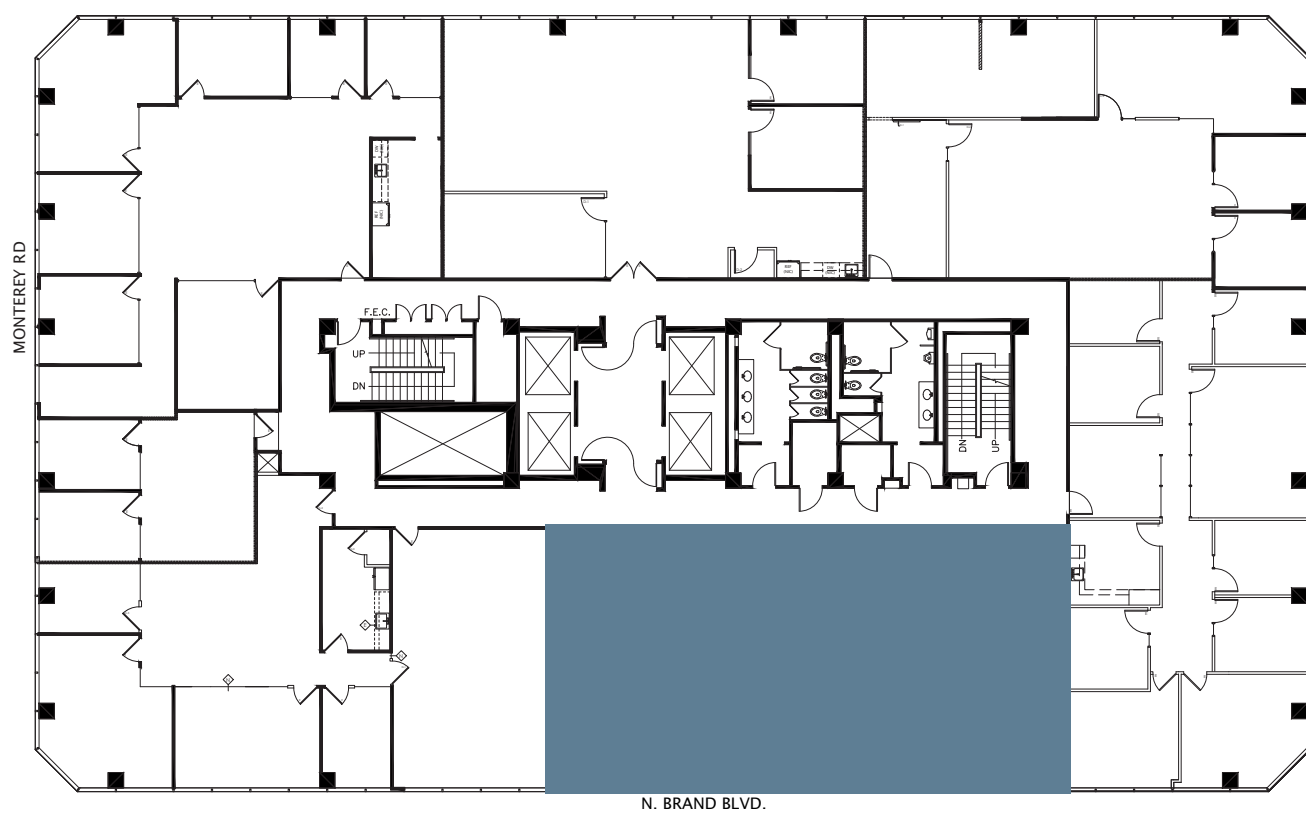

For leasing information please contact:
USALEASING@ONNI.COM
(213) 629-2041

