

SUITE: 370

RSF: 5,013



700 BRAND

AS-BUILT CONFIGURATION

RECEPTION.....	1
PRIVATE OFFICES.....	6
SHARED OFFICES.....	1
CONFERENCE ROOMS.....	2
OPEN WORK AREA.....	+/- 19

Not to scale, furniture and appliances not included

KEY PLAN

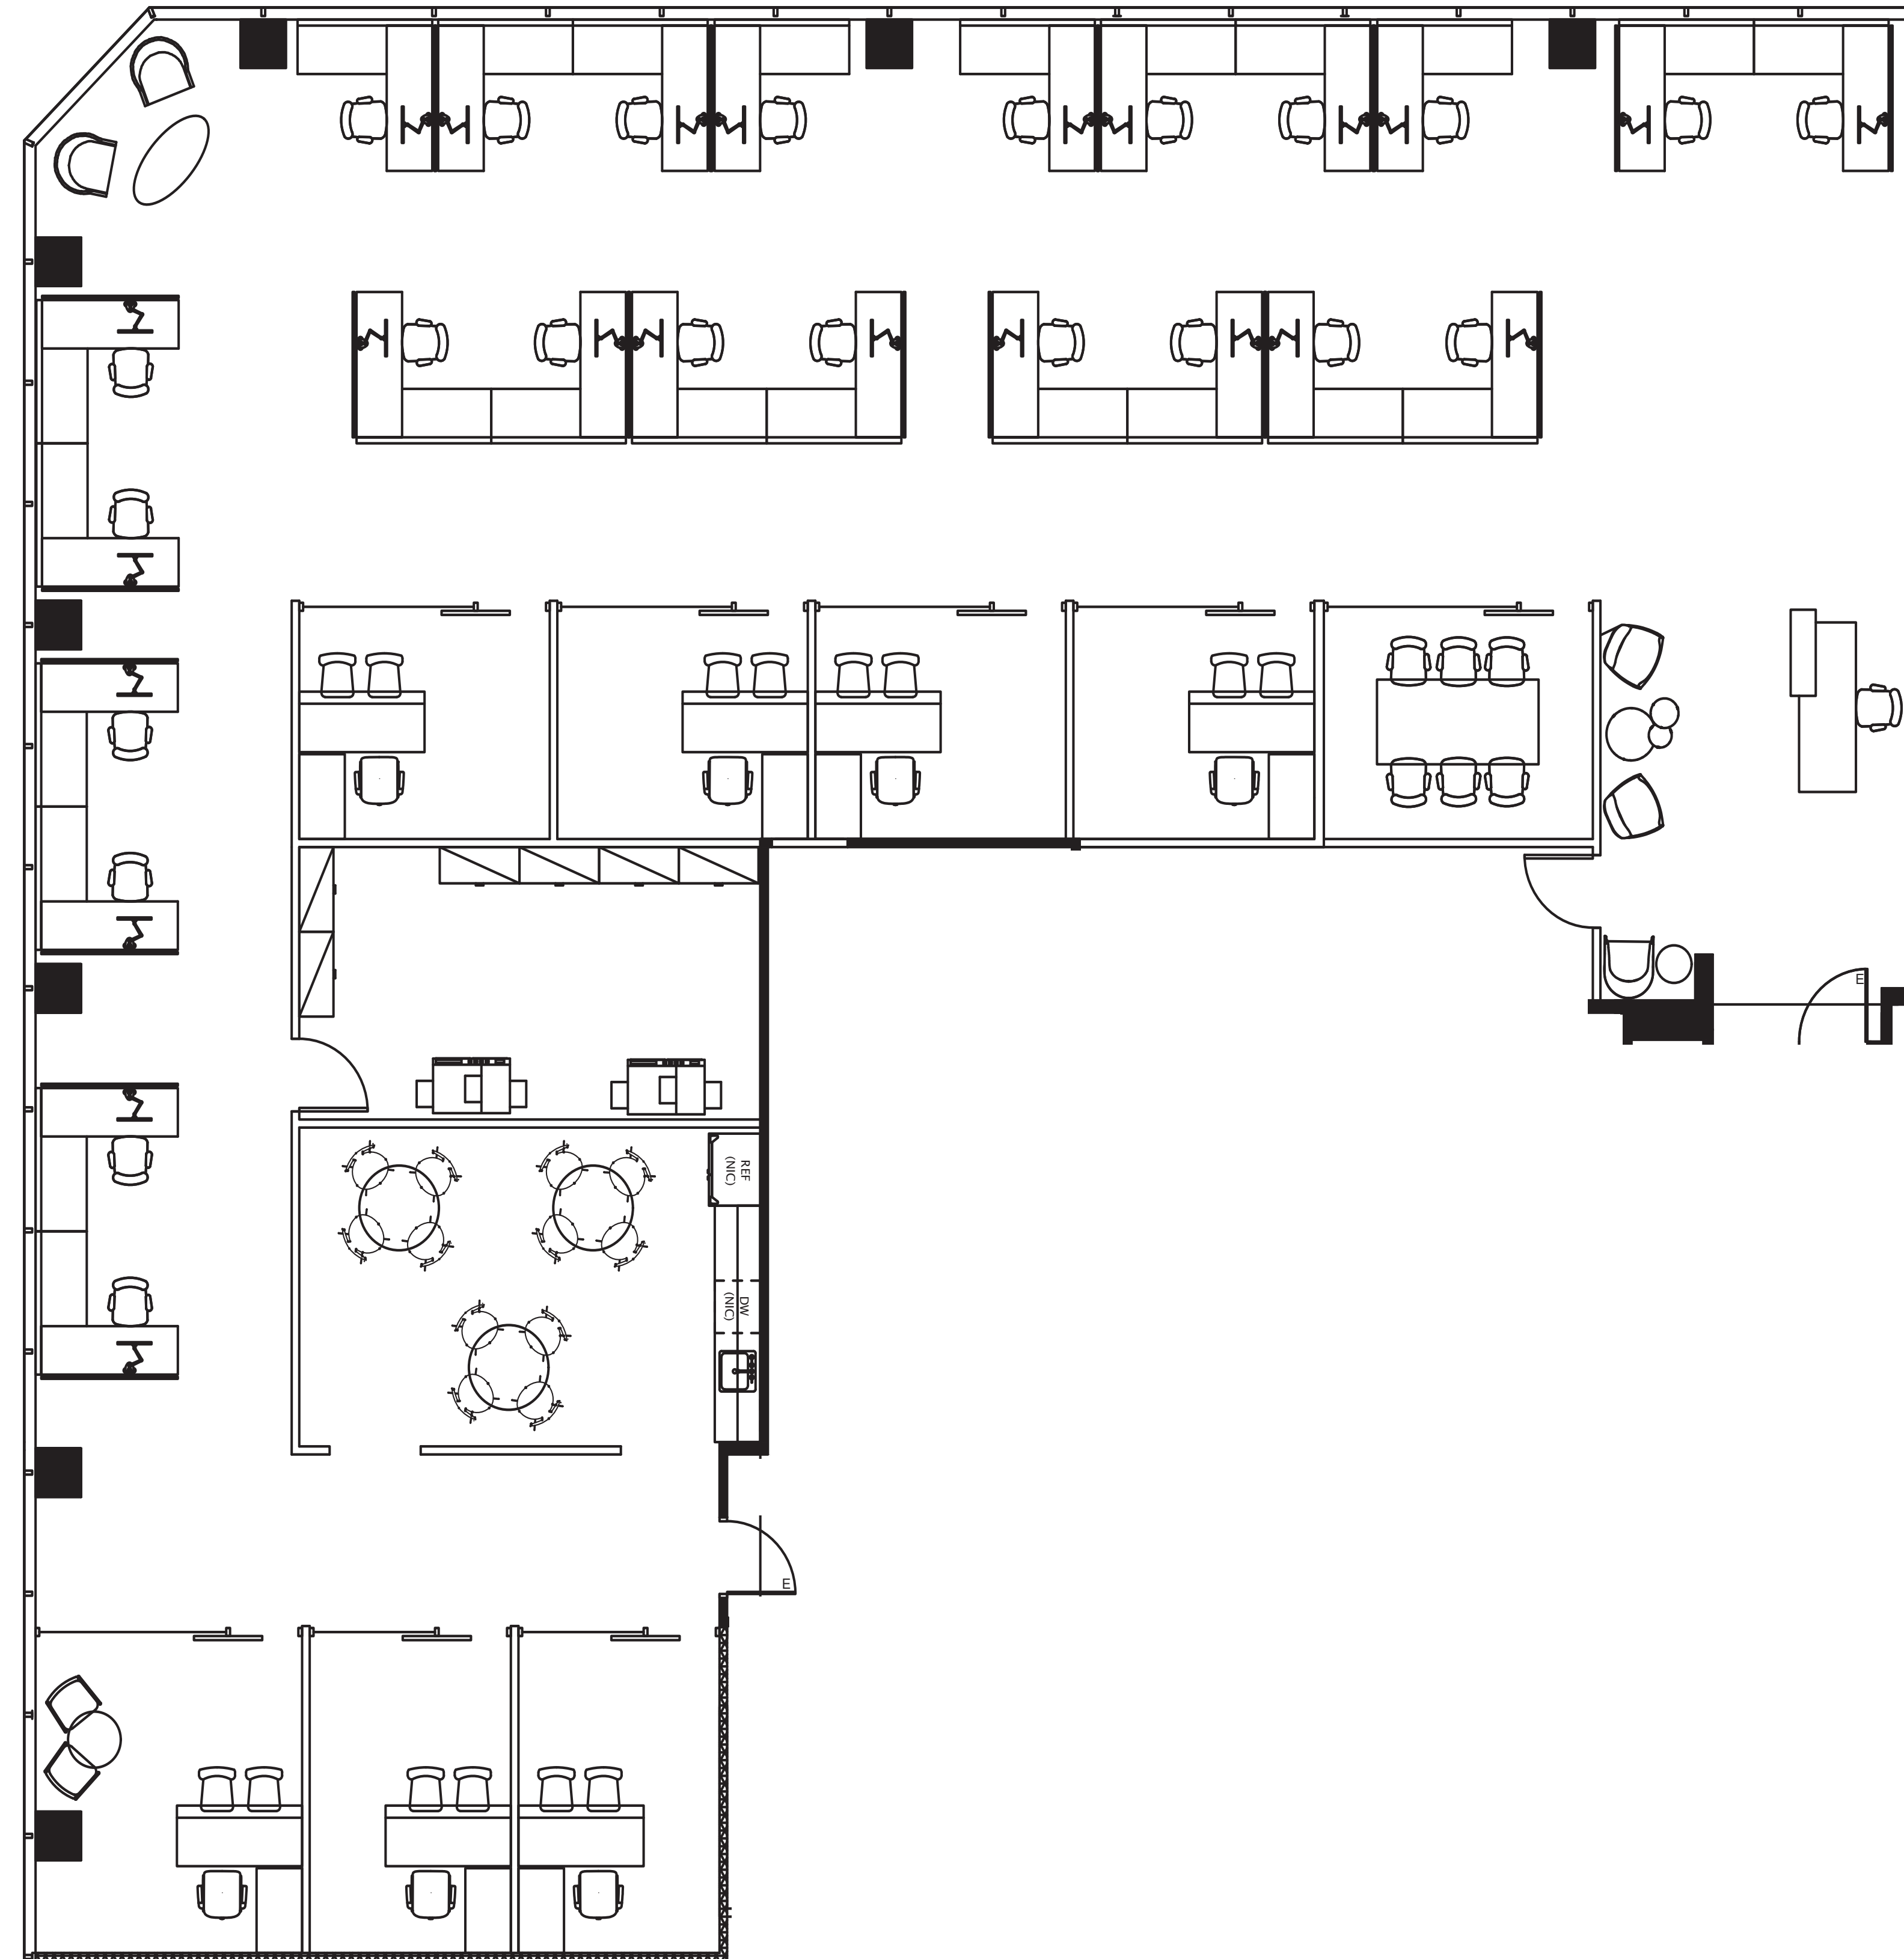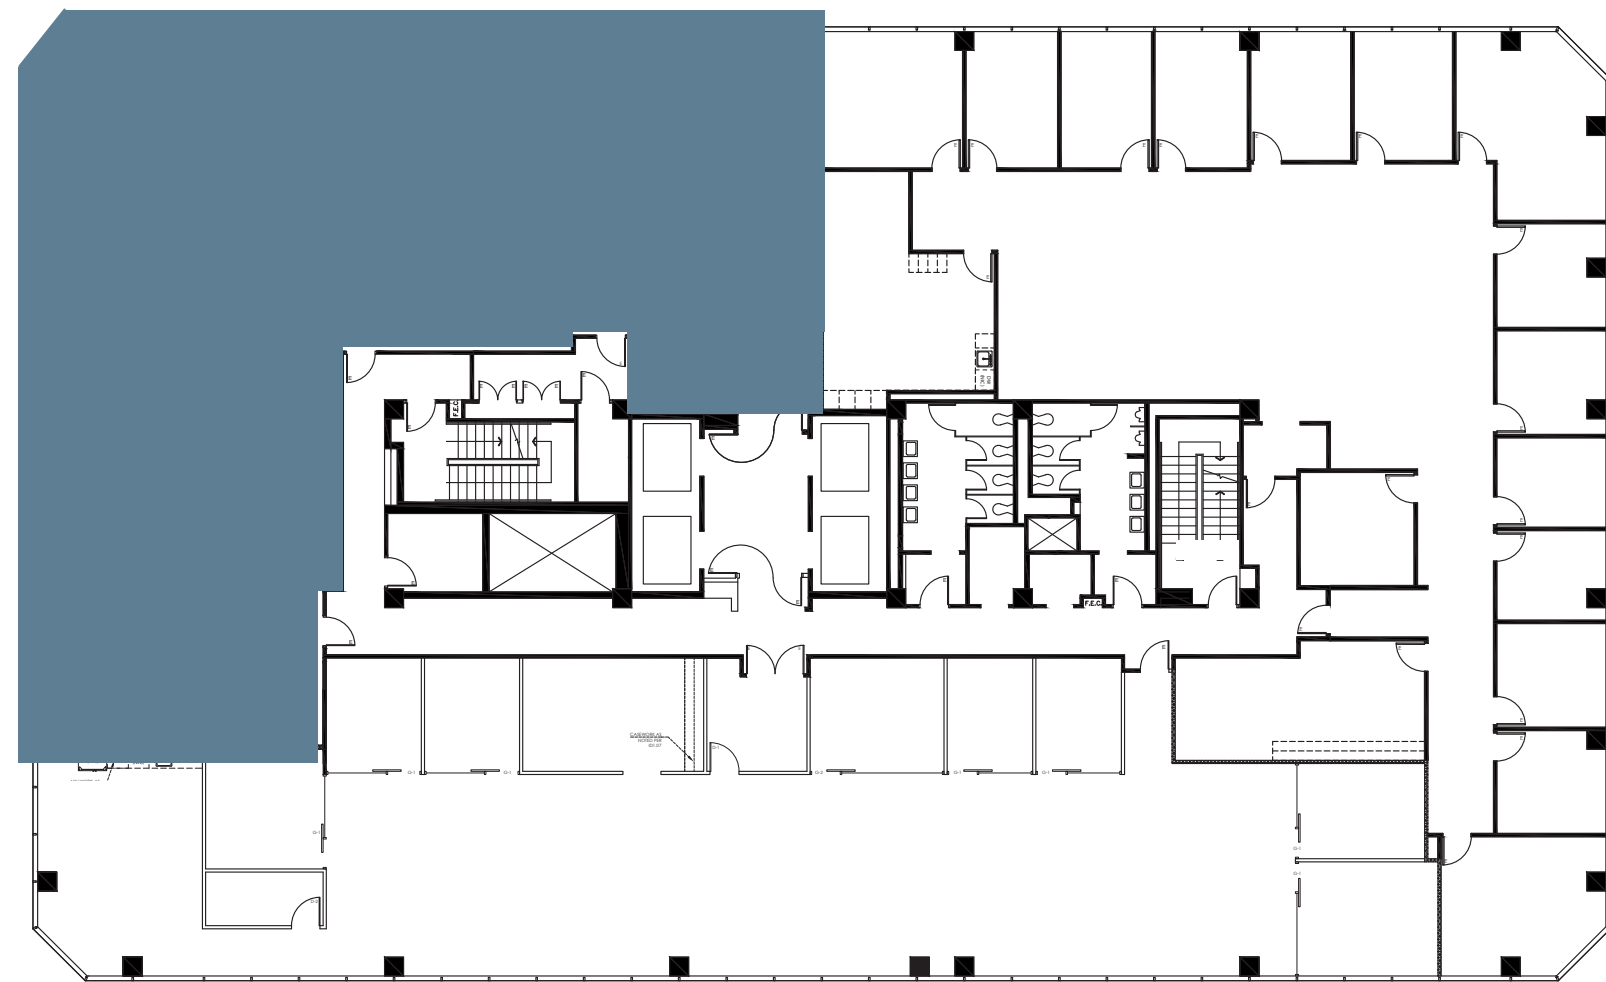

For leasing information please contact:
USALEASING@ONNI.COM
(213) 629-2041