
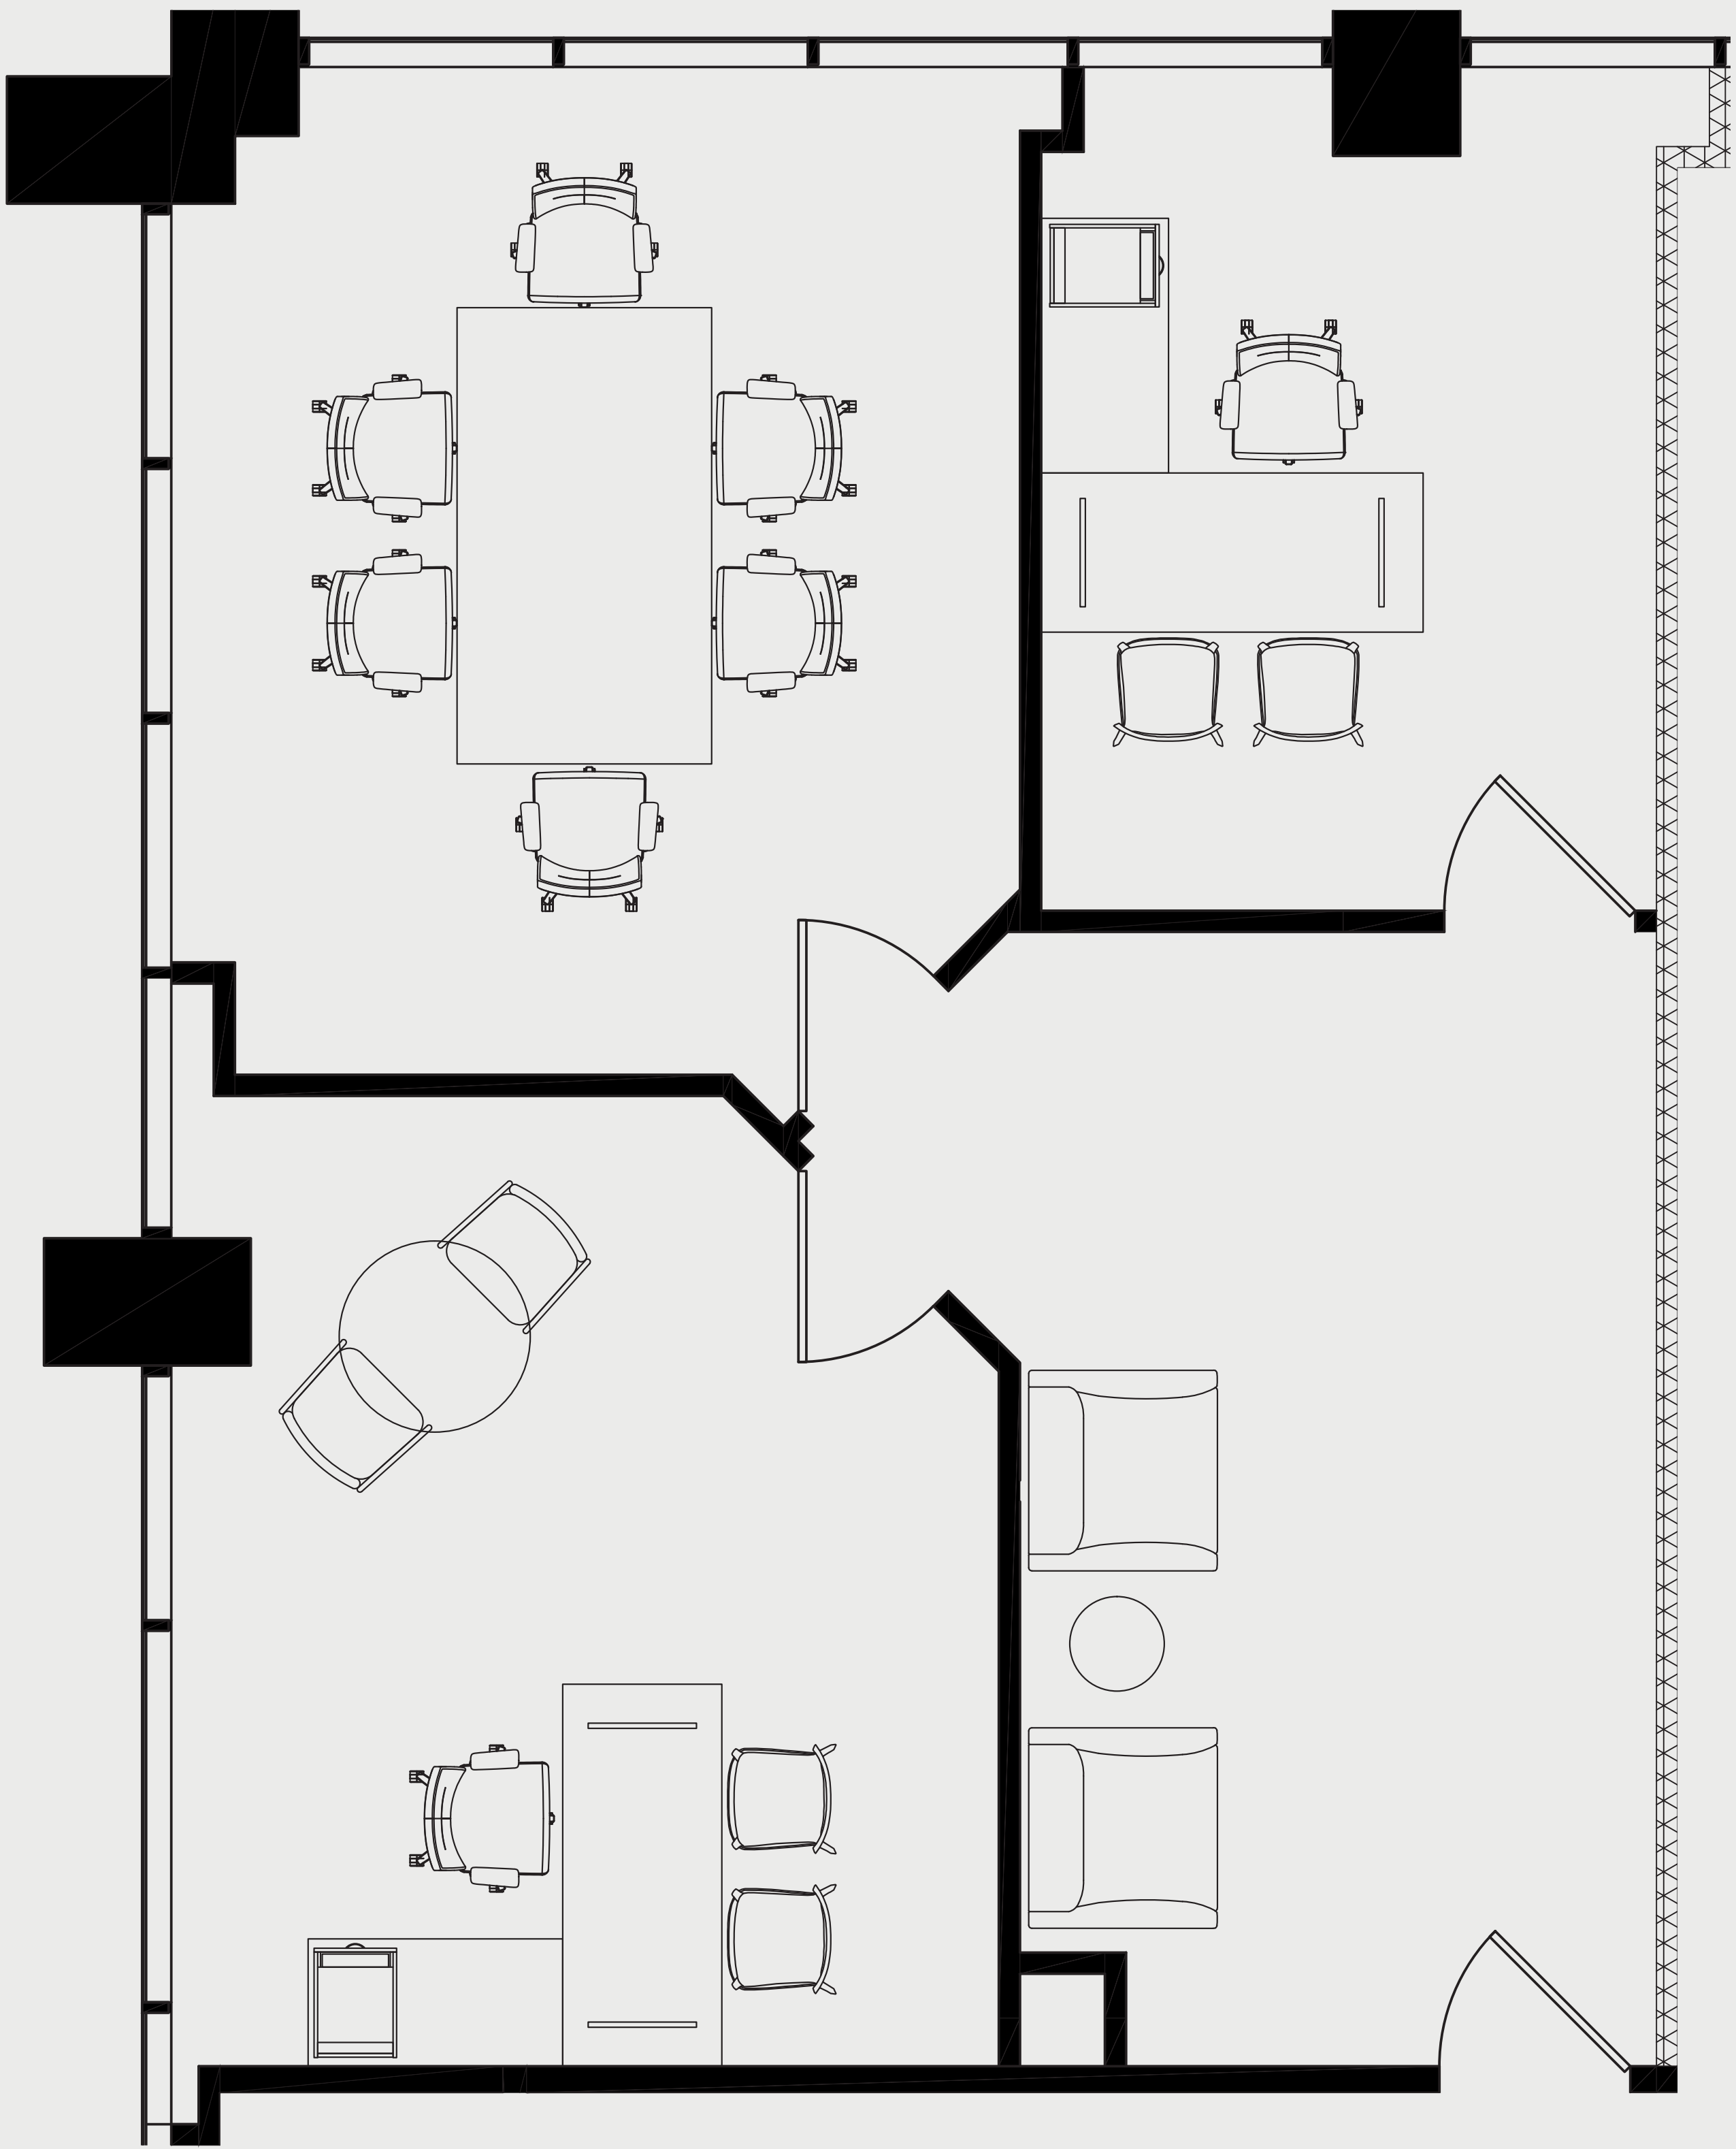


AS-BUILT CONFIGURATION

OFFICES.....	2
RECEPTION.....	1
CONFERENCE ROOMS.....	1
KITCHEN/BREAKOUT	N/A
OPEN WORK AREA.....	N/A

KEY PLAN

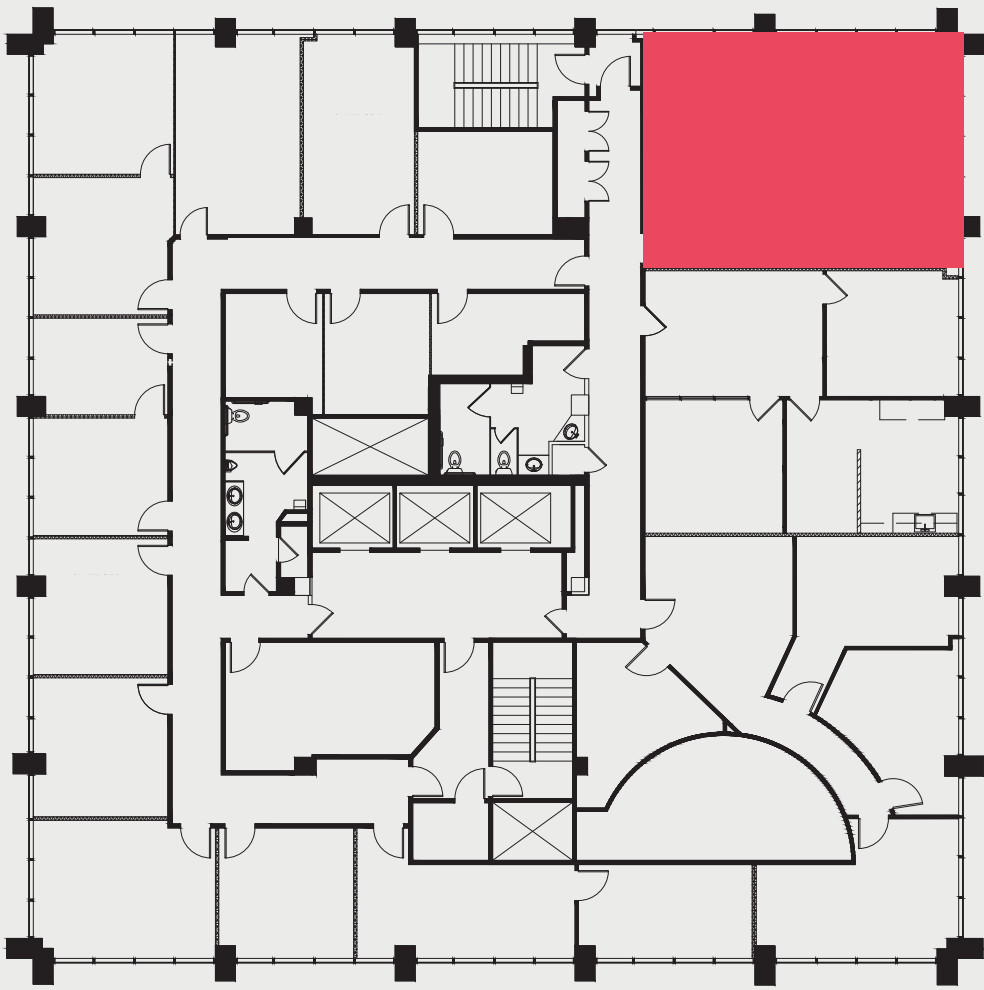

For leasing information please contact:

USALEASING@ONNI.COM
(213) 629-2041