

SUITE: 300



RSF: 4,505

535BRAND

AS-BUILT CONFIGURATION

OFFICES.....	7
RECEPTION.....	1
CONFERENCE ROOMS.....	3
KITCHEN/BREAKOUT	1
OPEN WORK AREA.....	+/- 7

KEY PLAN

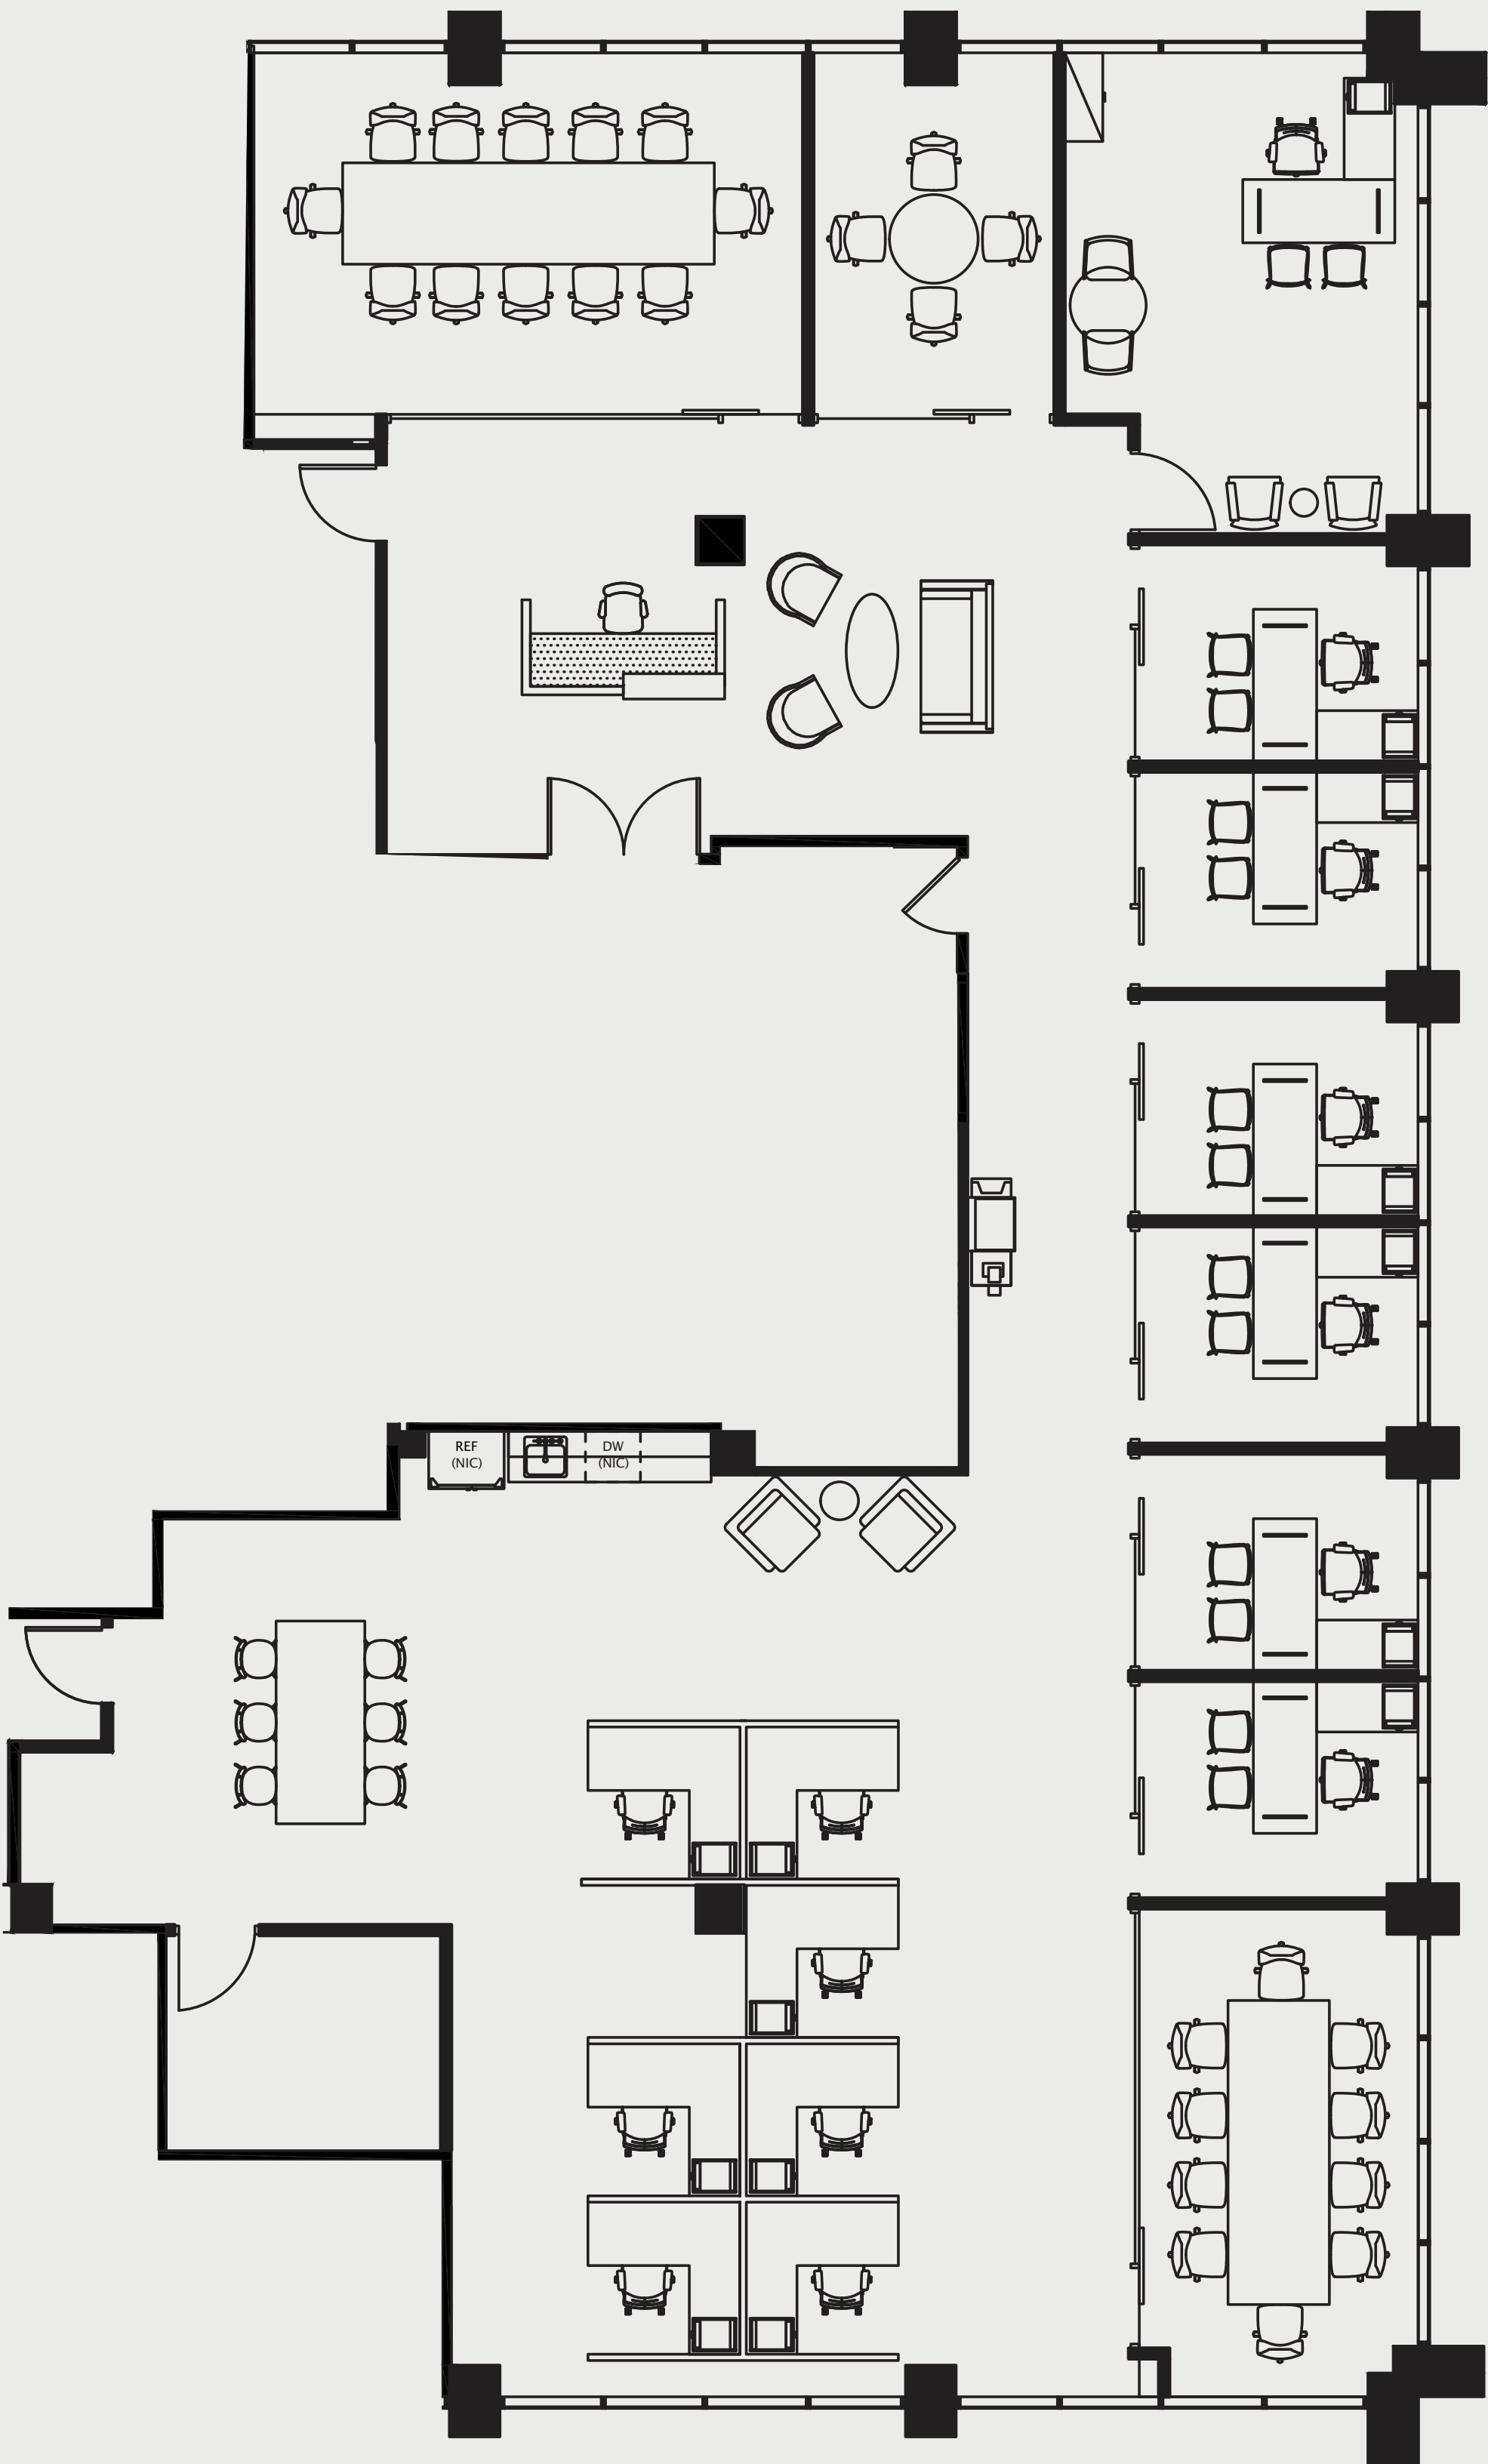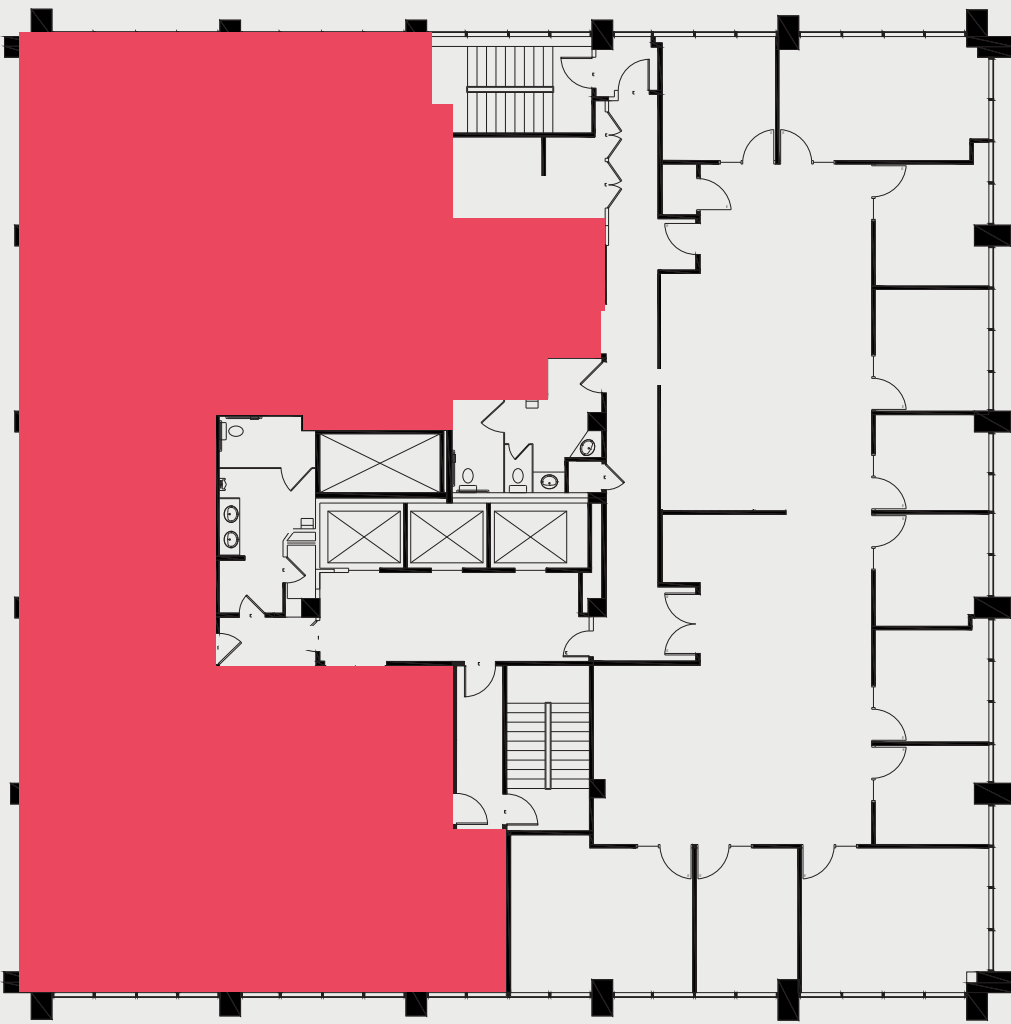

For leasing information please contact:
USALEASING@ONNI.COM
(213) 629-2041