

SUITE: 450



RSF: 2,409

535BRAND

AS-BUILT CONFIGURATION

- OFFICES..... 3
- RECEPTION..... 1
- CONFERENCE ROOMS..... 2
- KITCHEN/BREAKOUT 1
- OPEN WORK AREA..... +/- 6

KEY PLAN

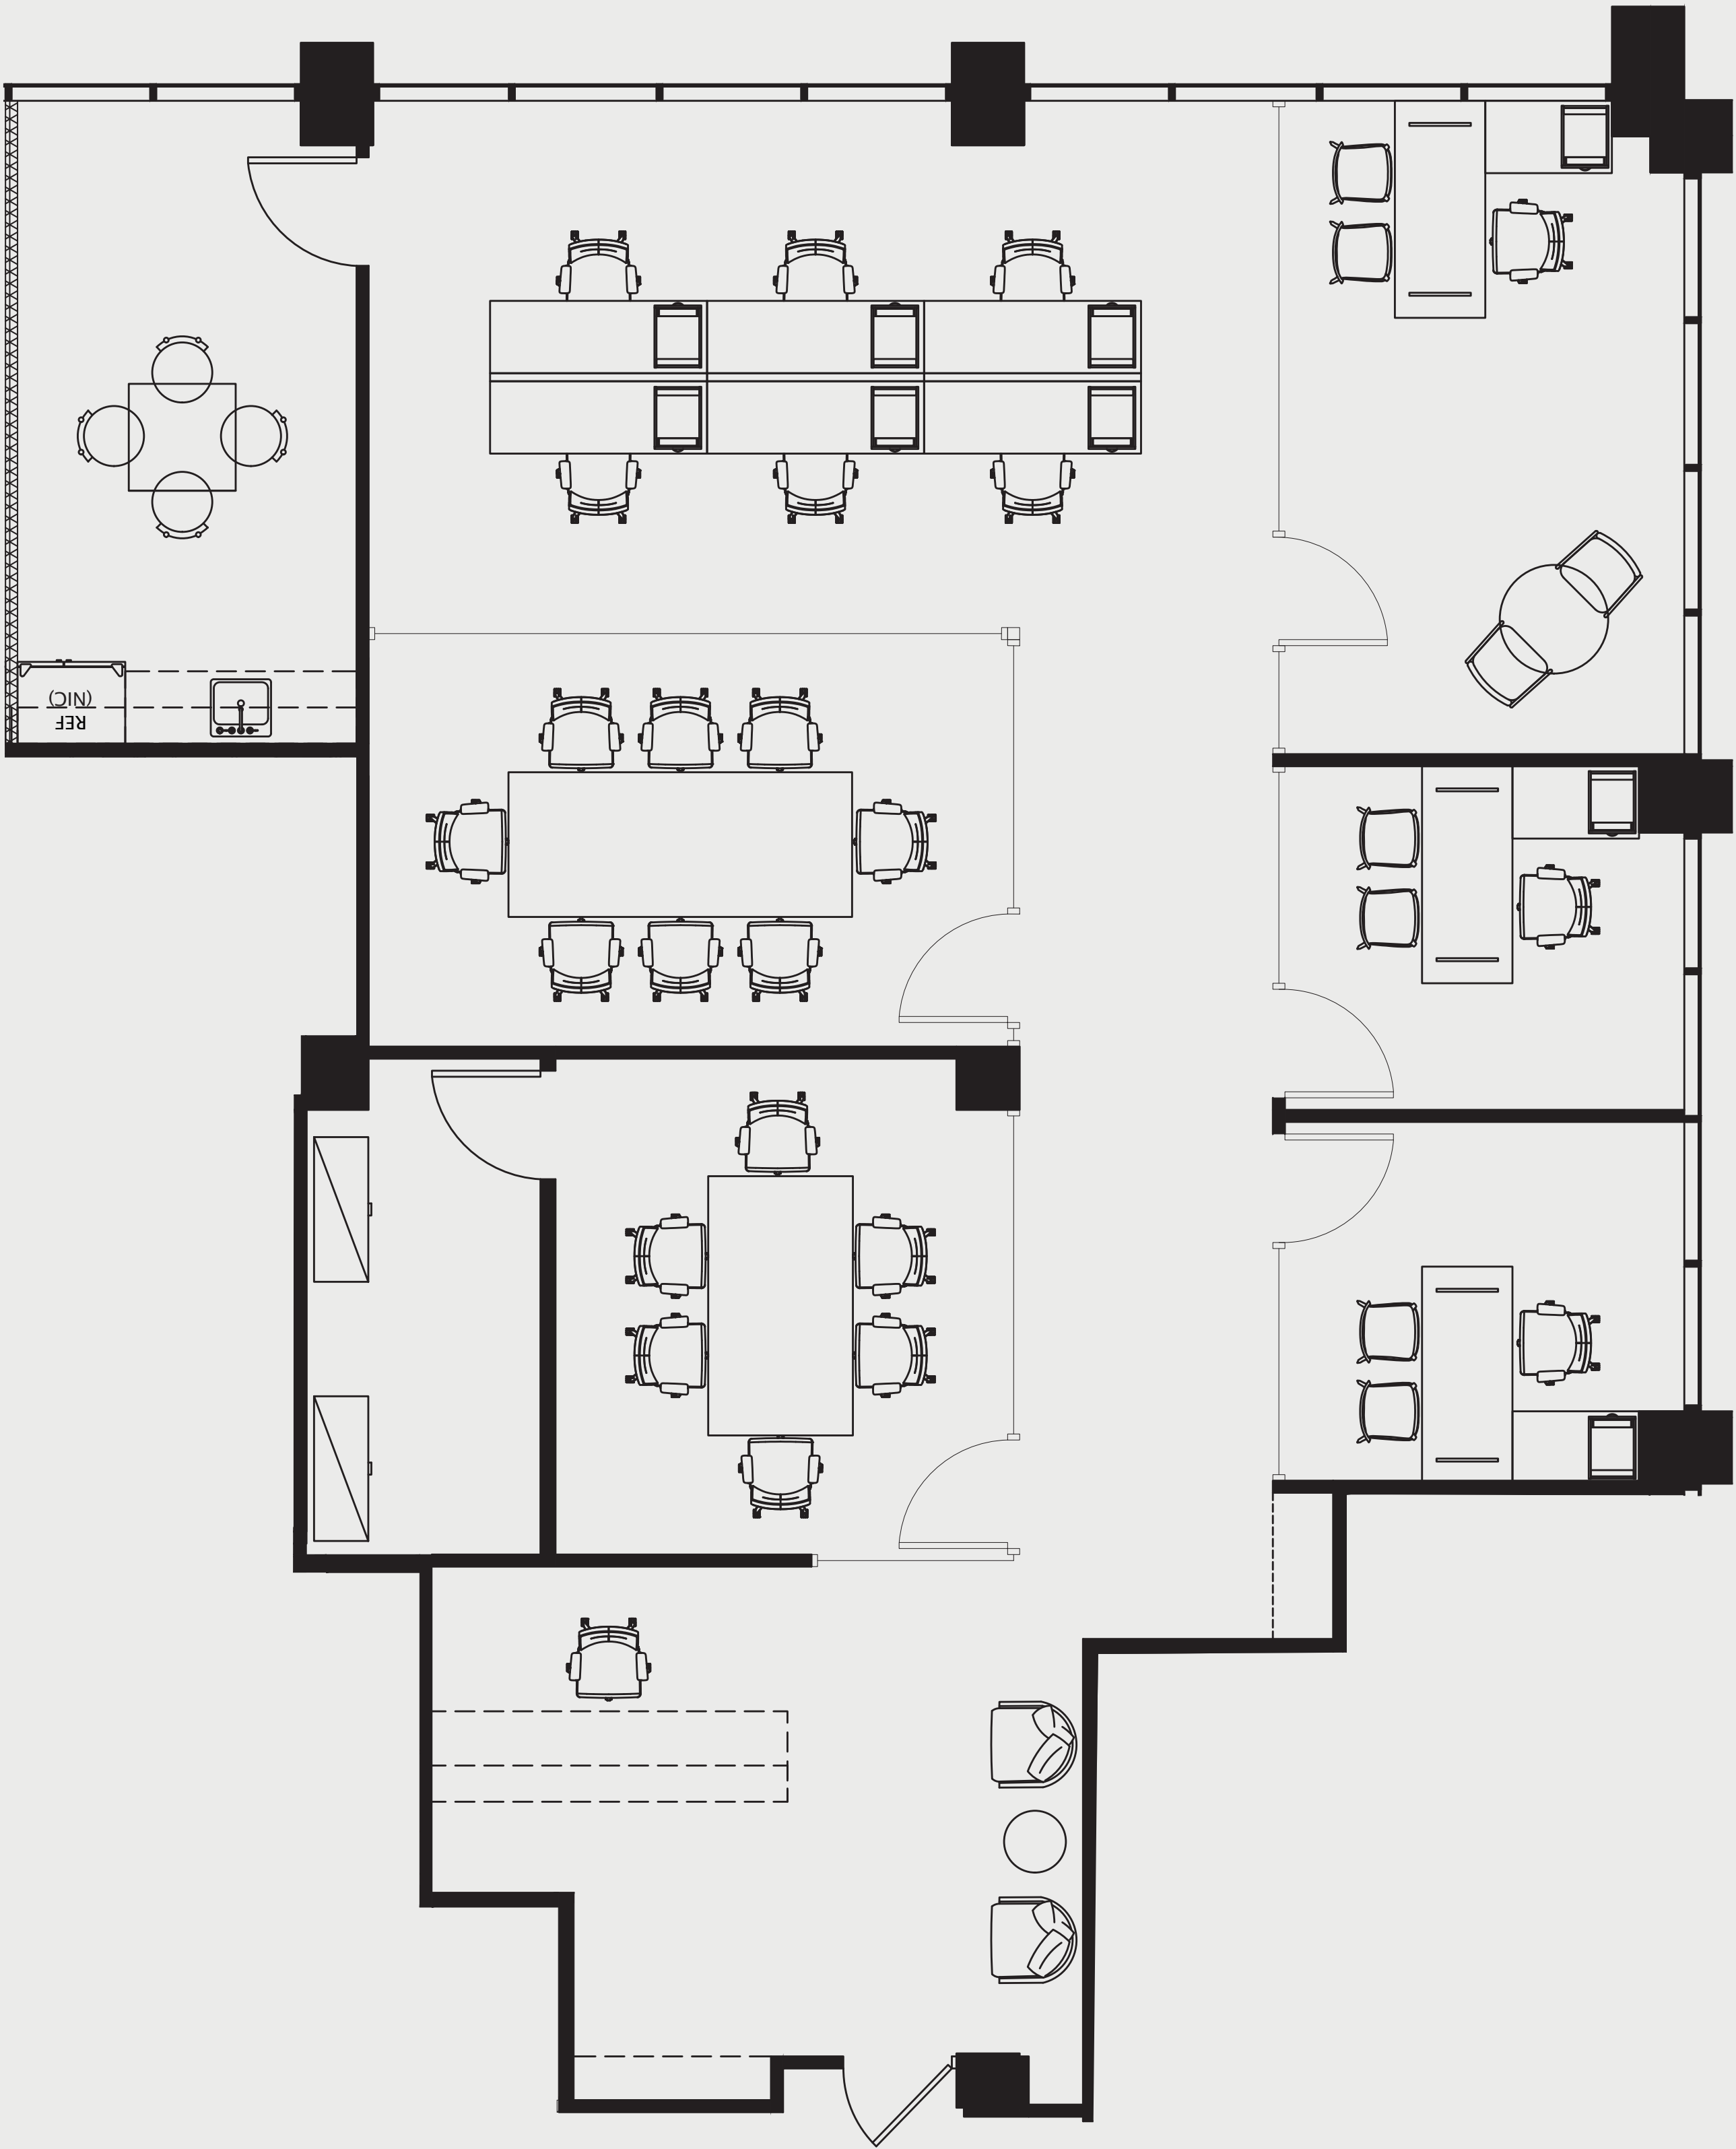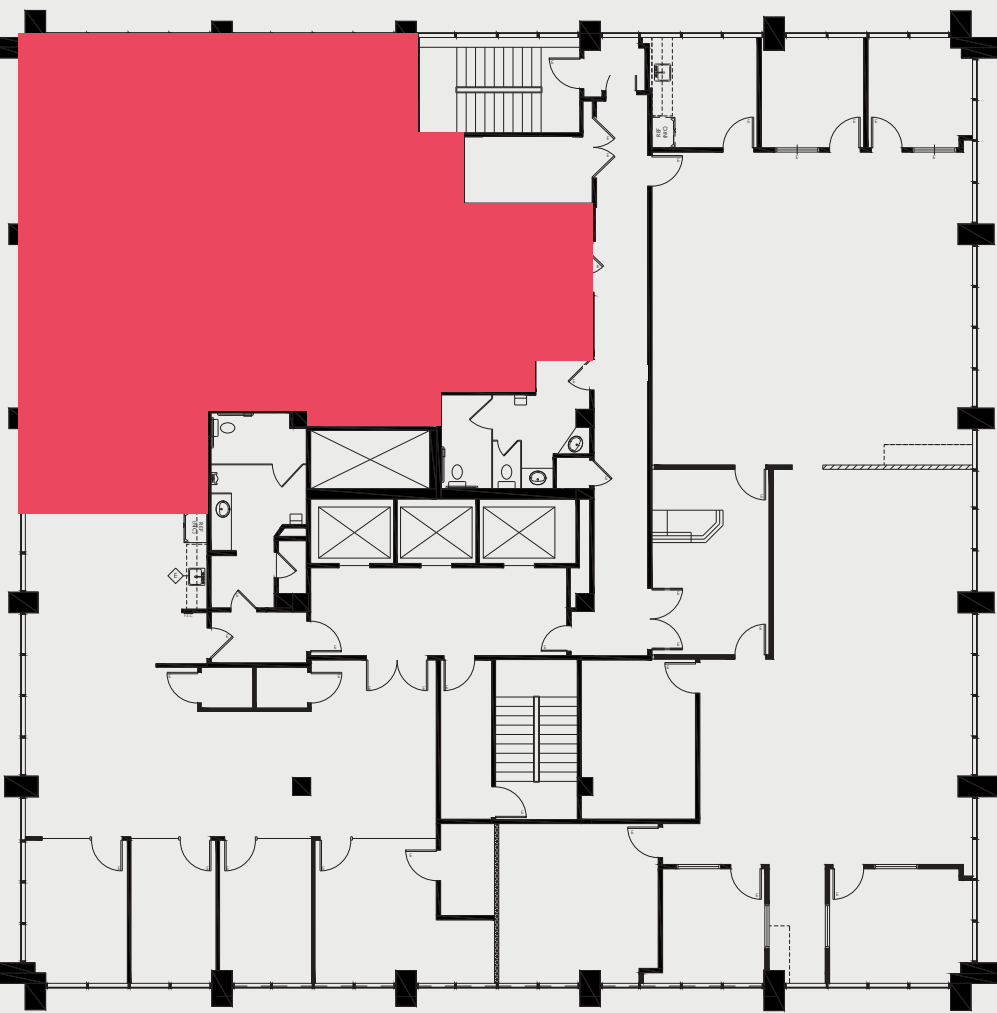

For leasing information please contact:

USALEASING@ONNI.COM
(213) 629-2041

