SUITE: 1150 RSF: 4,679

535BRAND

AS-BUILT CONFIGURATION

OFFICES..... 8


RECEPTION..... 1


CONFERENCE ROOMS.....2

KITCHEN/BREAKOUT 1

OPEN WORK AREA..... +/- 12

KEY PLAN

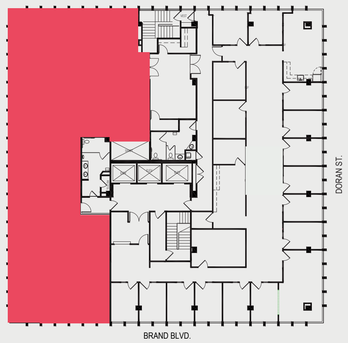

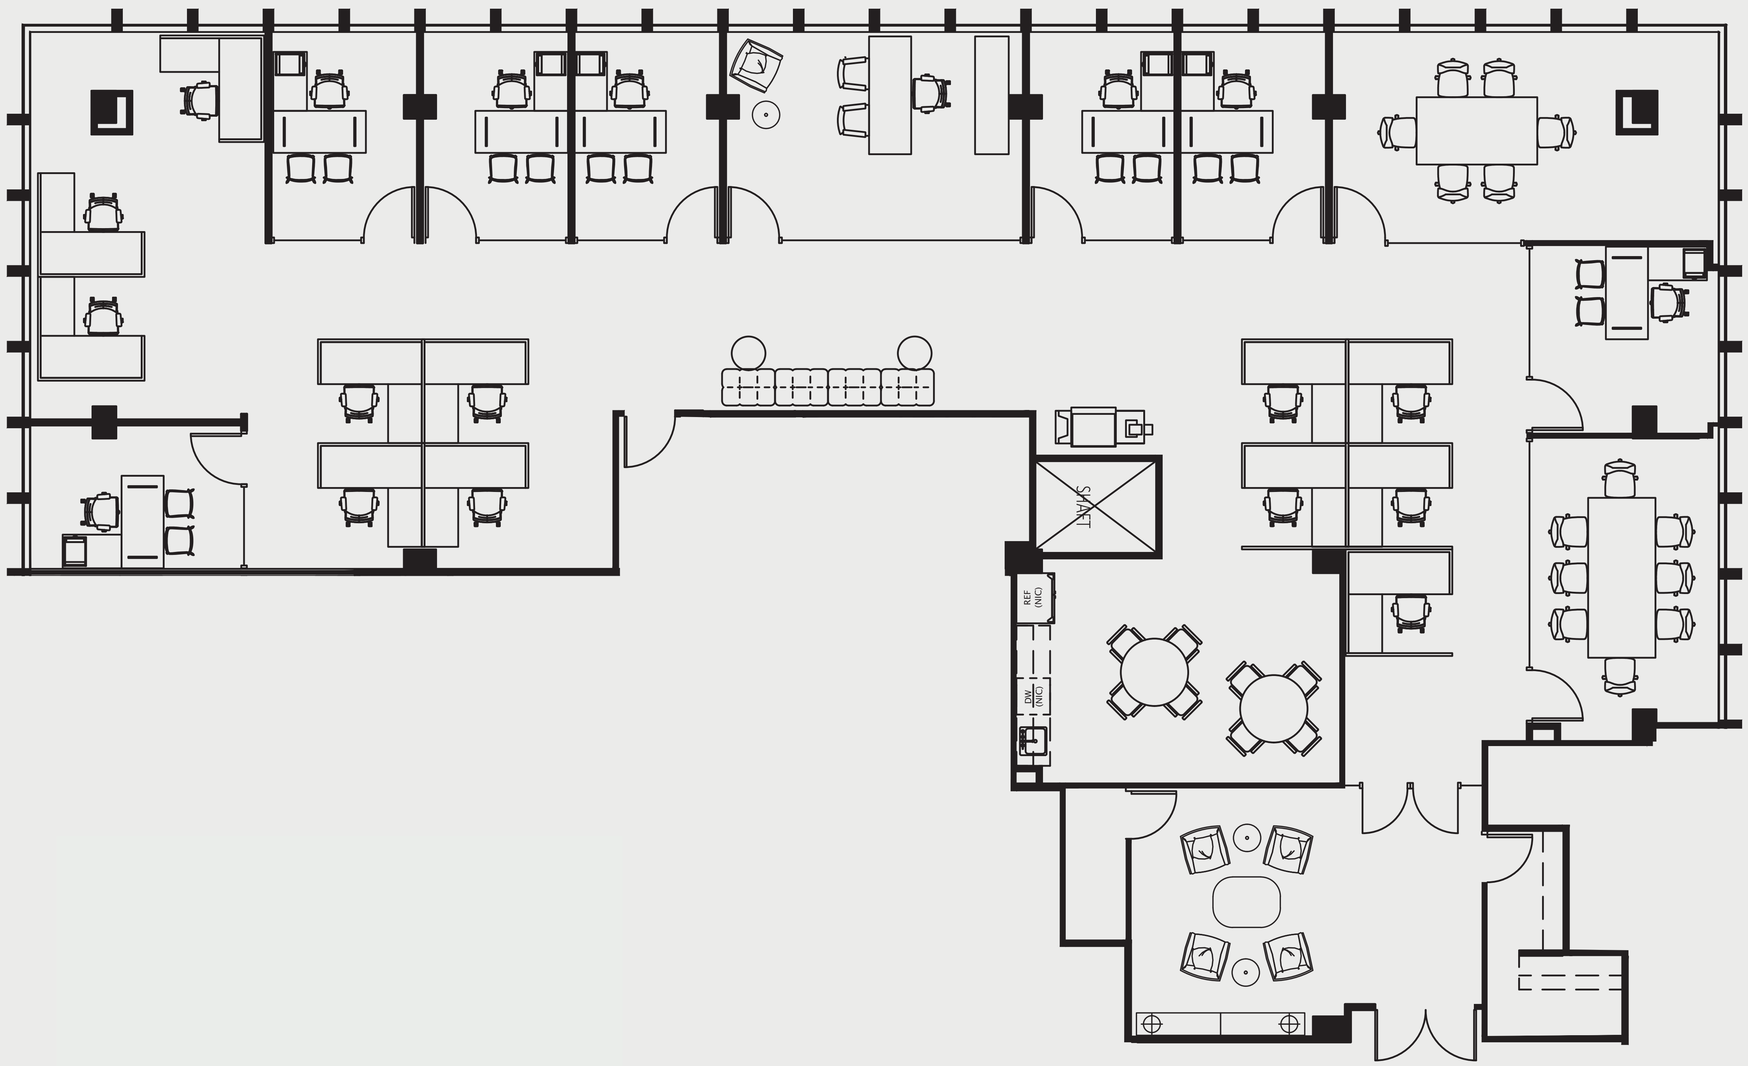

onni group