SUITE: 580 RSF: 1,225

700BRAND

AS-BUILT CONFIGURATION

OFFICES..... 2

RECEPTION..... 1

CONFERENCE ROOMS..... 1


KITCHEN..... 1


OPEN WORK AREA.....±/- 2

Not to scale, furniture and appliances not included

KEY PLAN

Not to scale, furniture and appliances not included

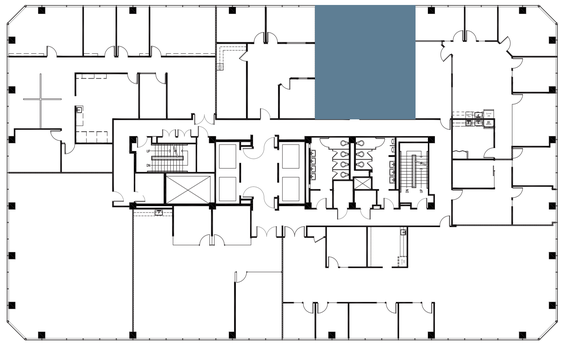

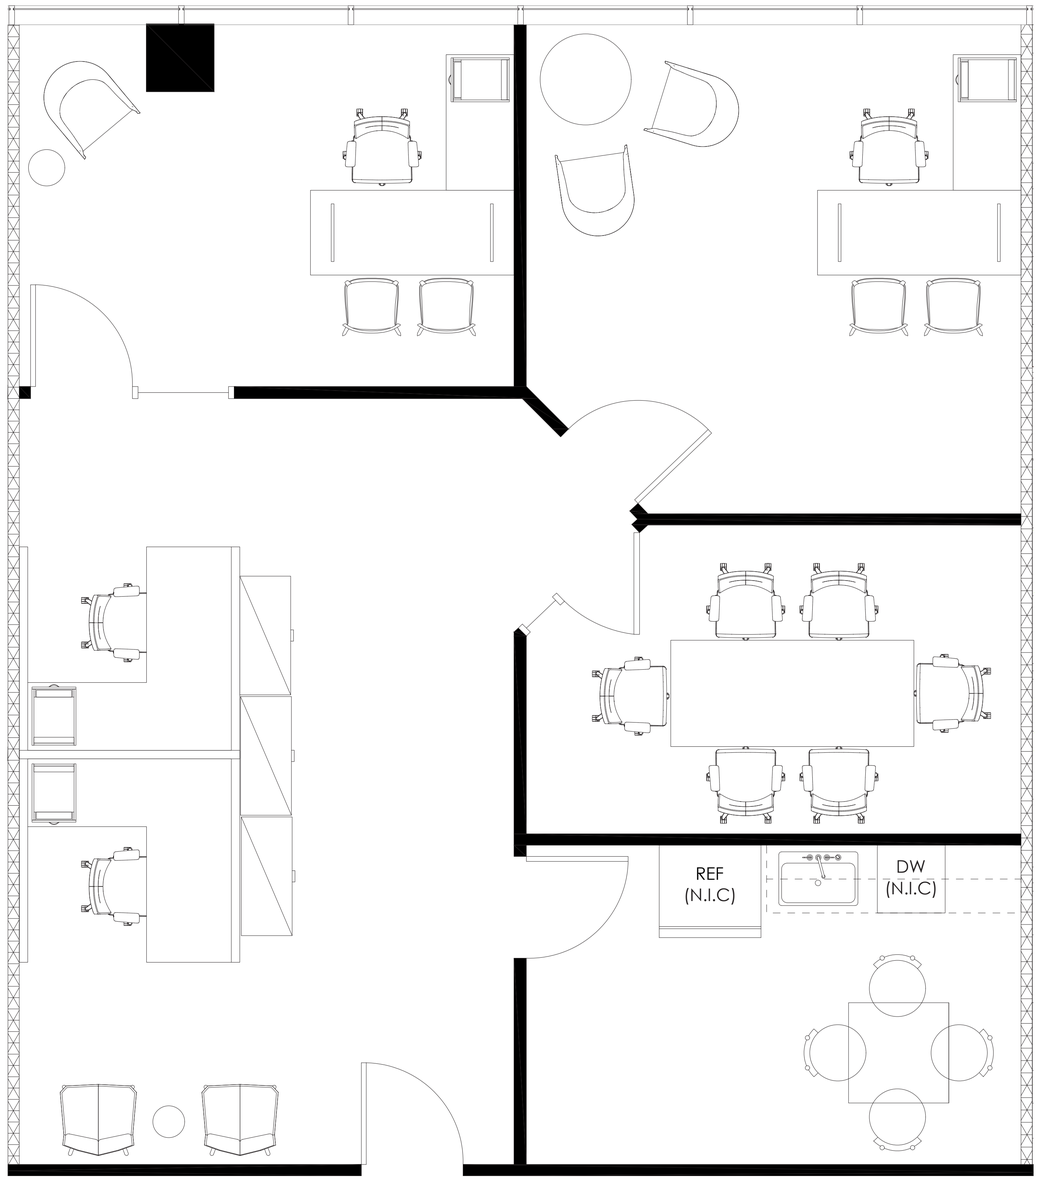

For leasing information please contact:
USALEASING@ONNI.COM
(213) 629-2041

onni group