SUITE: 620 RSF: 1,738

700BRAND


AS-BUILT CONFIGURATION

OFFICES.....	3
CONFERENCE ROOMS.....	1
KITCHEN.....	1
OPEN WORK AREA.....	+/- 6

Not to scale, furniture and appliances not included

KEY PLAN



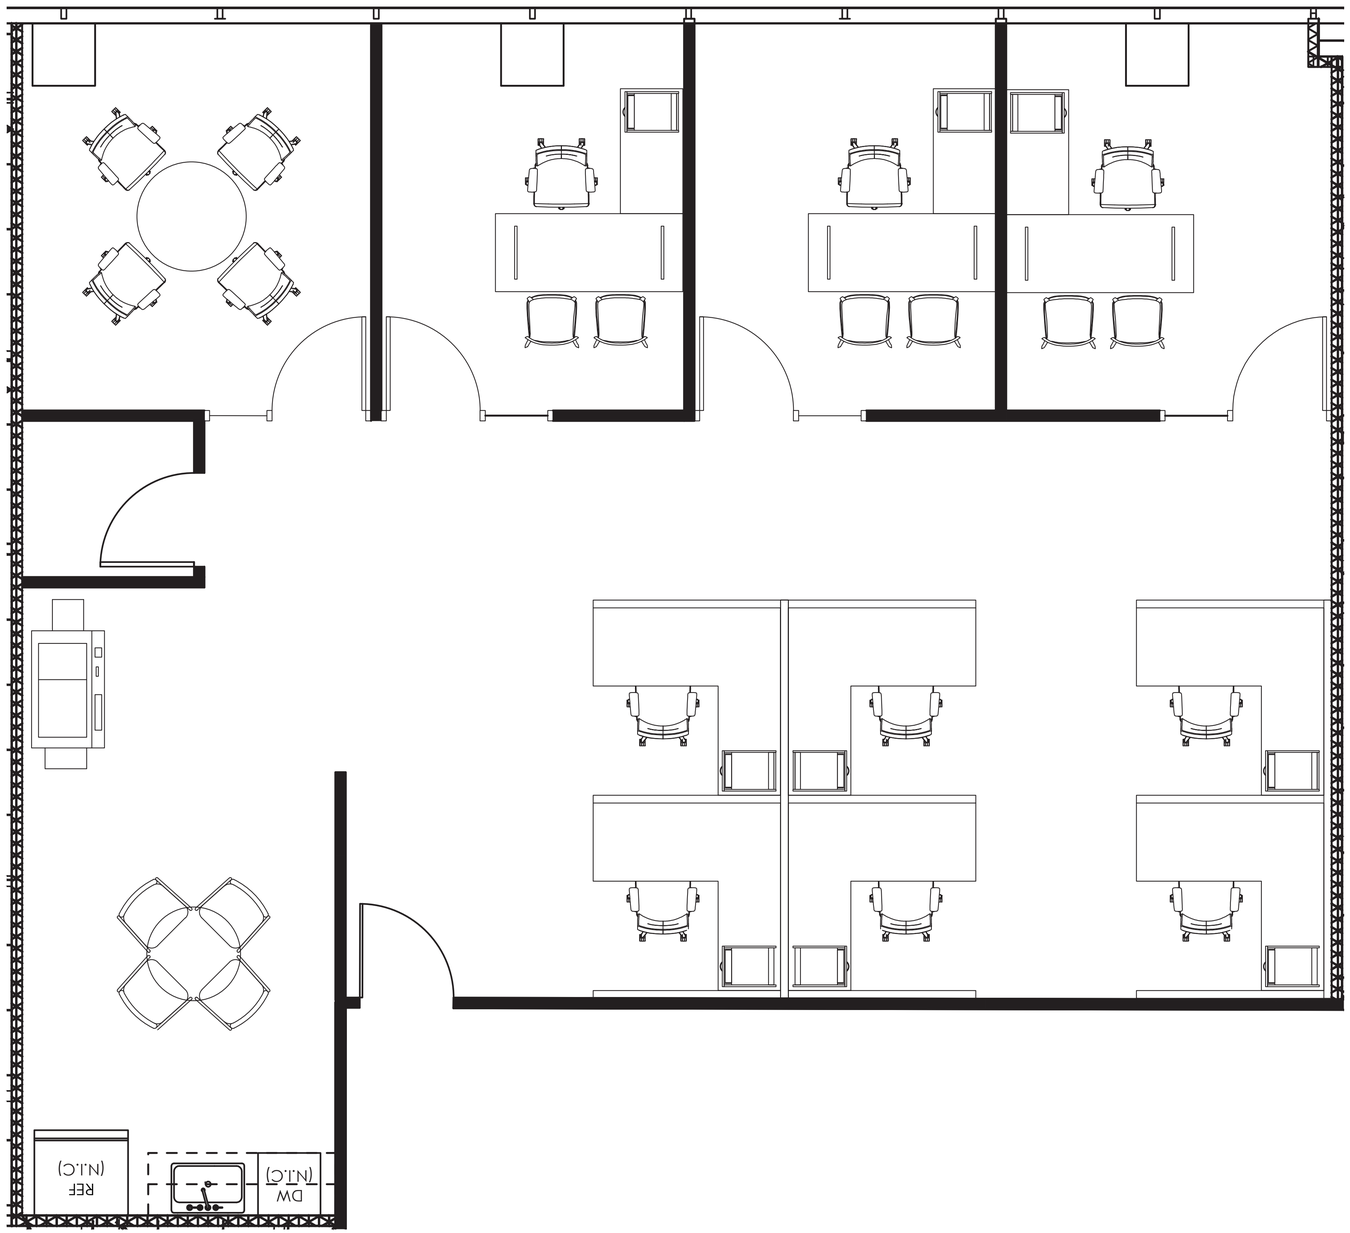

For leasing information please contact:
USALEASING@ONNI.COM
(213) 629-2041

onni group®