SUITE: 835 RSF: 2,440


700BRAND


AS-BUILT CONFIGURATION

OFFICES	5
CONFERENCE ROOMS	1
KITCHEN	1
OPEN WORK AREA	+/- 8

Not to scale, furniture and appliances not included

KEY PLAN

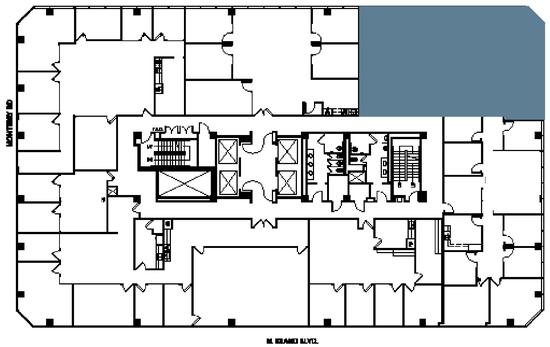

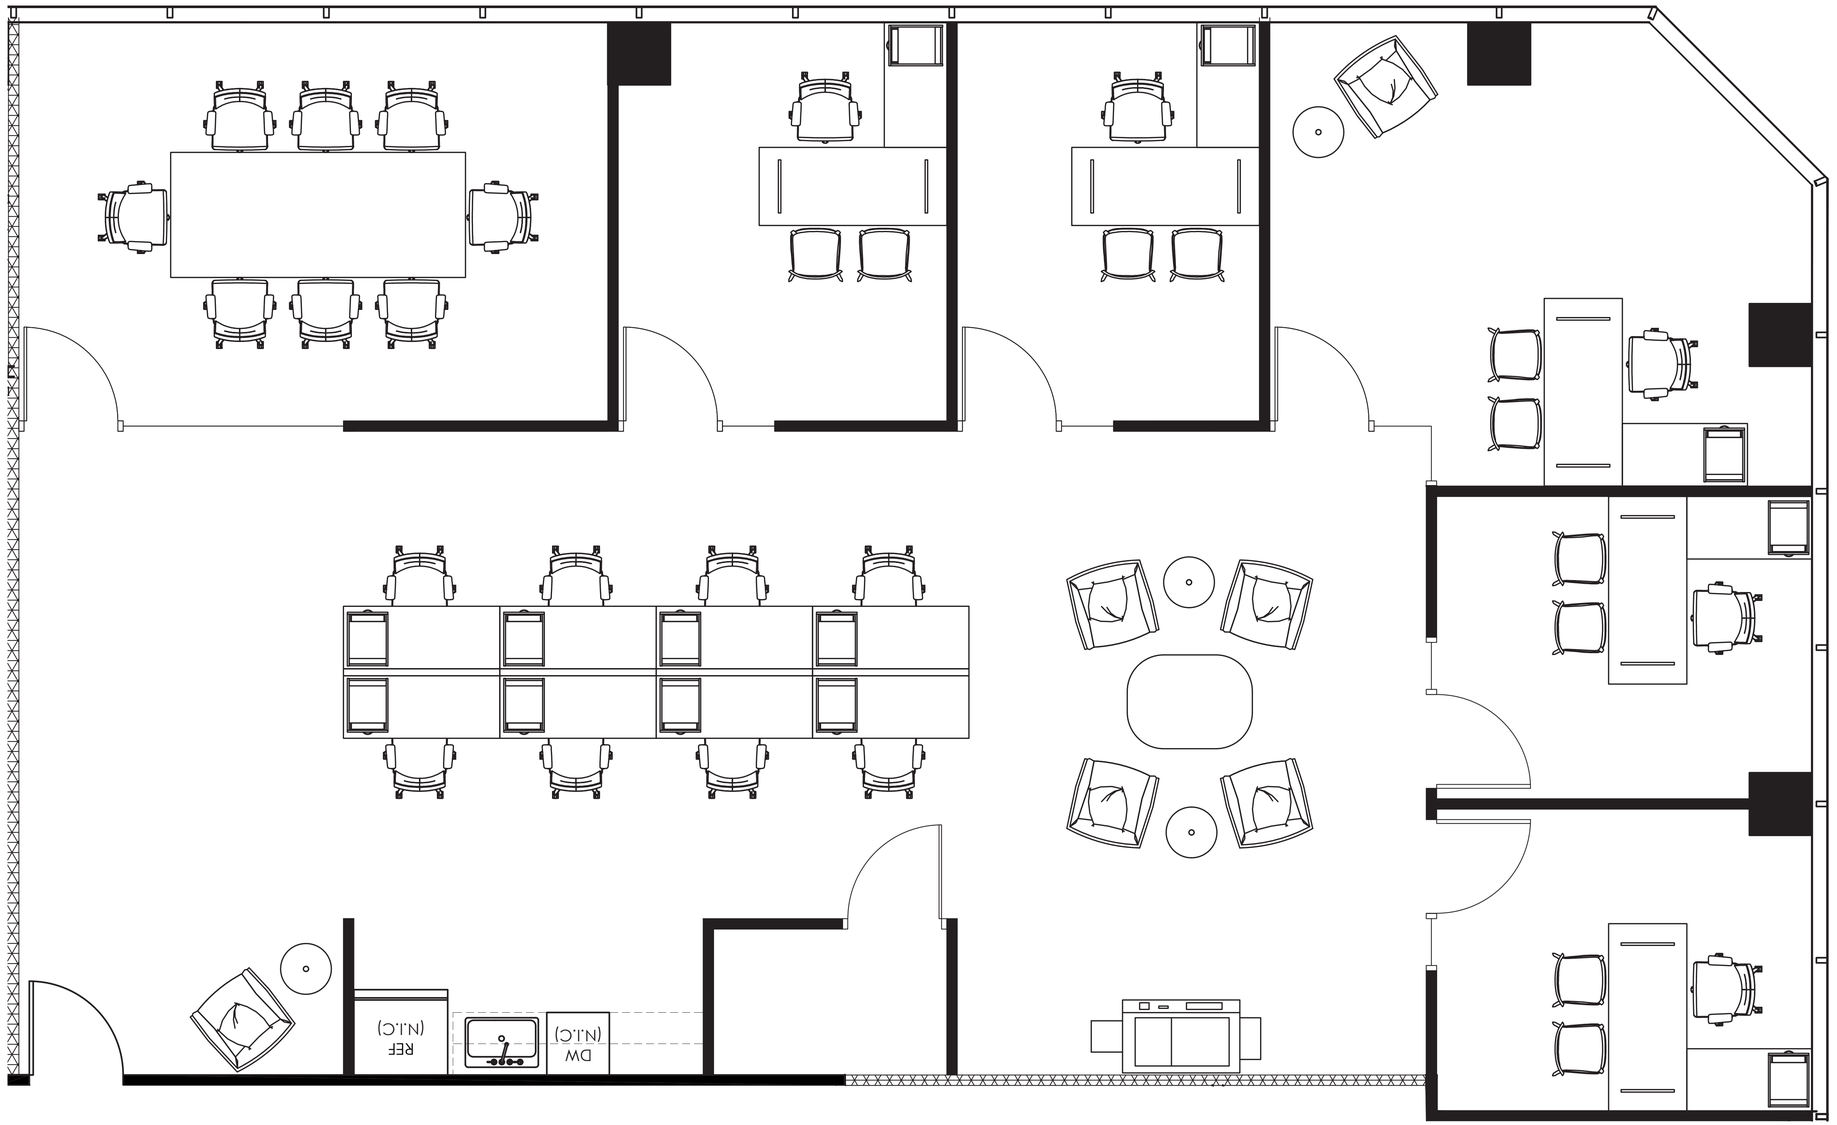

For leasing information please contact:
USALEASING@ONNI.COM
(213) 629-2041

onni group